


This design is based on generally accepted practices and standards at the time it was prepared. No other warranty, expressed or implied, is made. It is prepared in accordance with the scope of work and for the purpose outlined in the contract dated 27 Sept 2012. No responsibility is accepted for use of any part of this design in any other context or for any other purpose. URS accepts no liability for the use of this drawing where it has been provided in electronic format, nor for any changes made to it following its issue. URS considers the printed version to be binding. A hard copy of this drawing is held on file by URS and may be provided if requested.

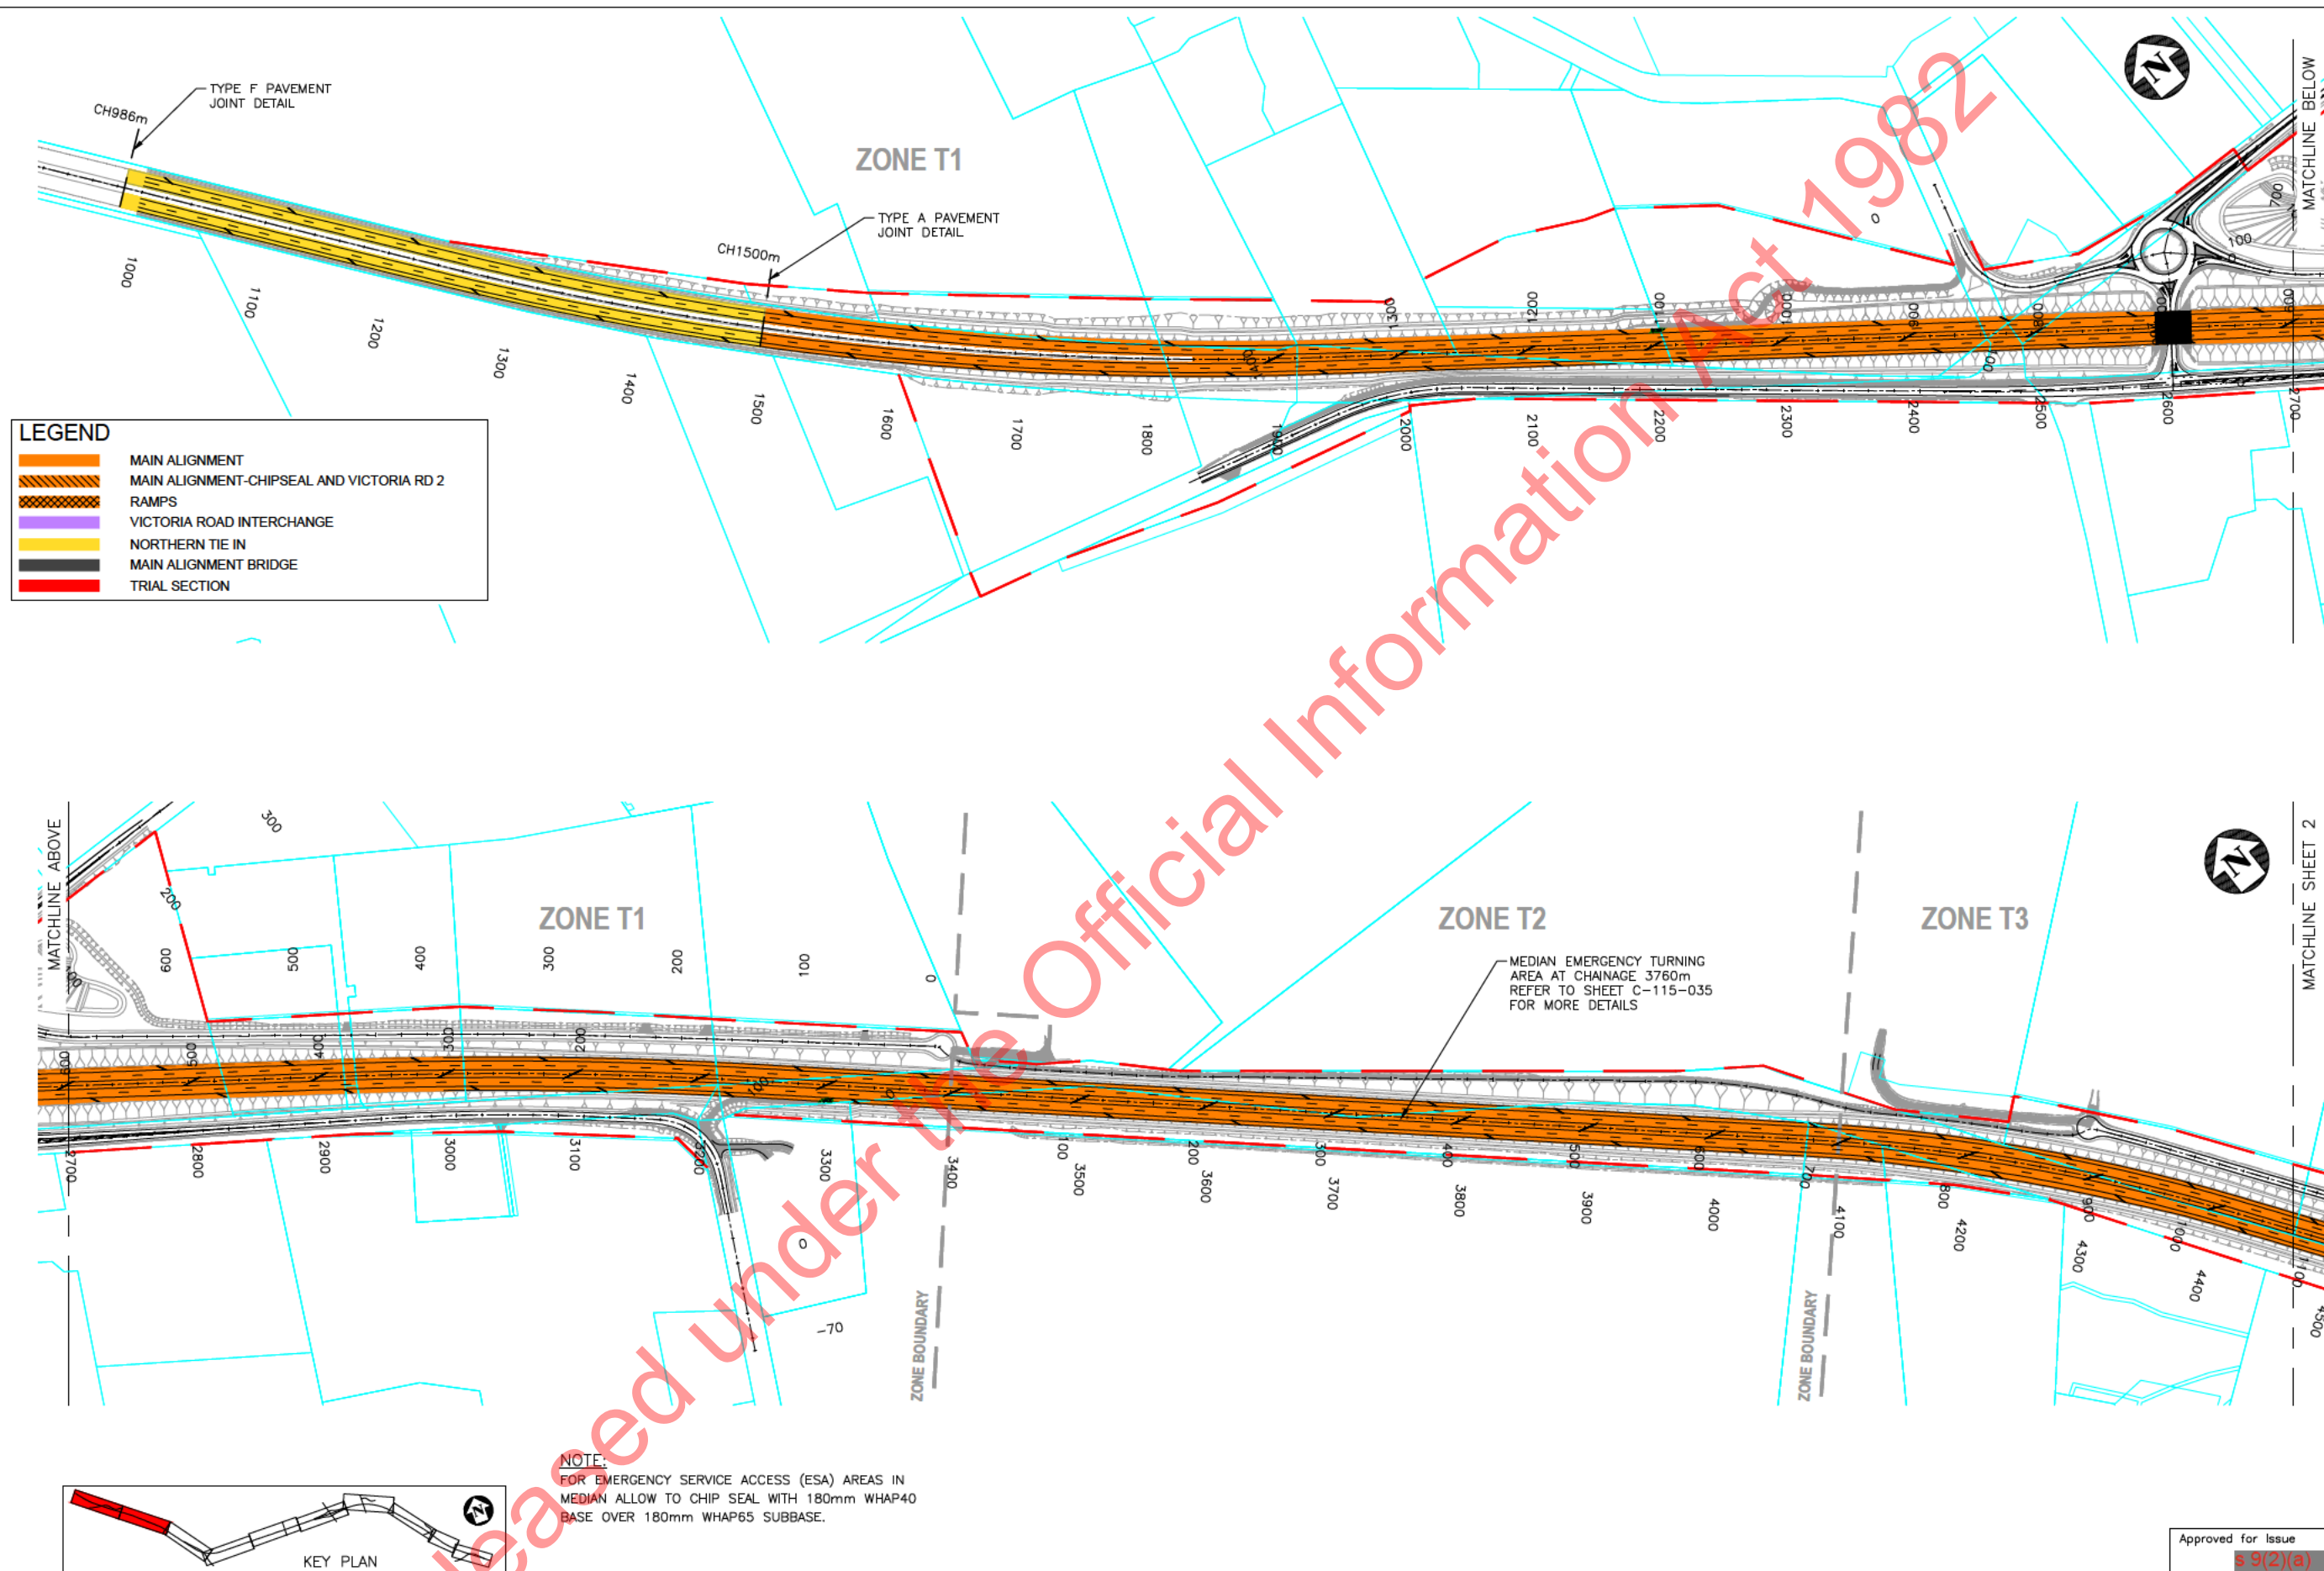


Rev	Revision Description	Drawn	Checked	Designed	Design Checked	Approved	Date
01	AS-BUILT AMENDED						12.06.17
02	AS-BUILT						16.09.15


Tob	101
Scales	1:2500 A1 1:5000 A3
Original Size	A1

WAIKATO EXPRESSWAY: TAMAHERE TO CAMBRIDGE SECTION	
PAVEMENT TYPES EXPRESSWAY AND RAMPS SHEET 1 OF 5	
Status	AS-BUILT
Drawing Number	C-115-101
Revision	01

This design is based on generally accepted practices and standards at the time it was prepared. No other warranty, expressed or implied, is made. It is prepared in accordance with the scope of work and for the purpose outlined in the contract dated 27 Sept 2012. No responsibility is accepted for use of any part of this design in any other context or for any other purpose. URS accepts no liability for the use of this drawing where it has been provided in electronic format, nor for any changes made to it following its issue. URS considers the printed version to be binding. A hard copy of this drawing is held on file by URS and may be provided if requested.

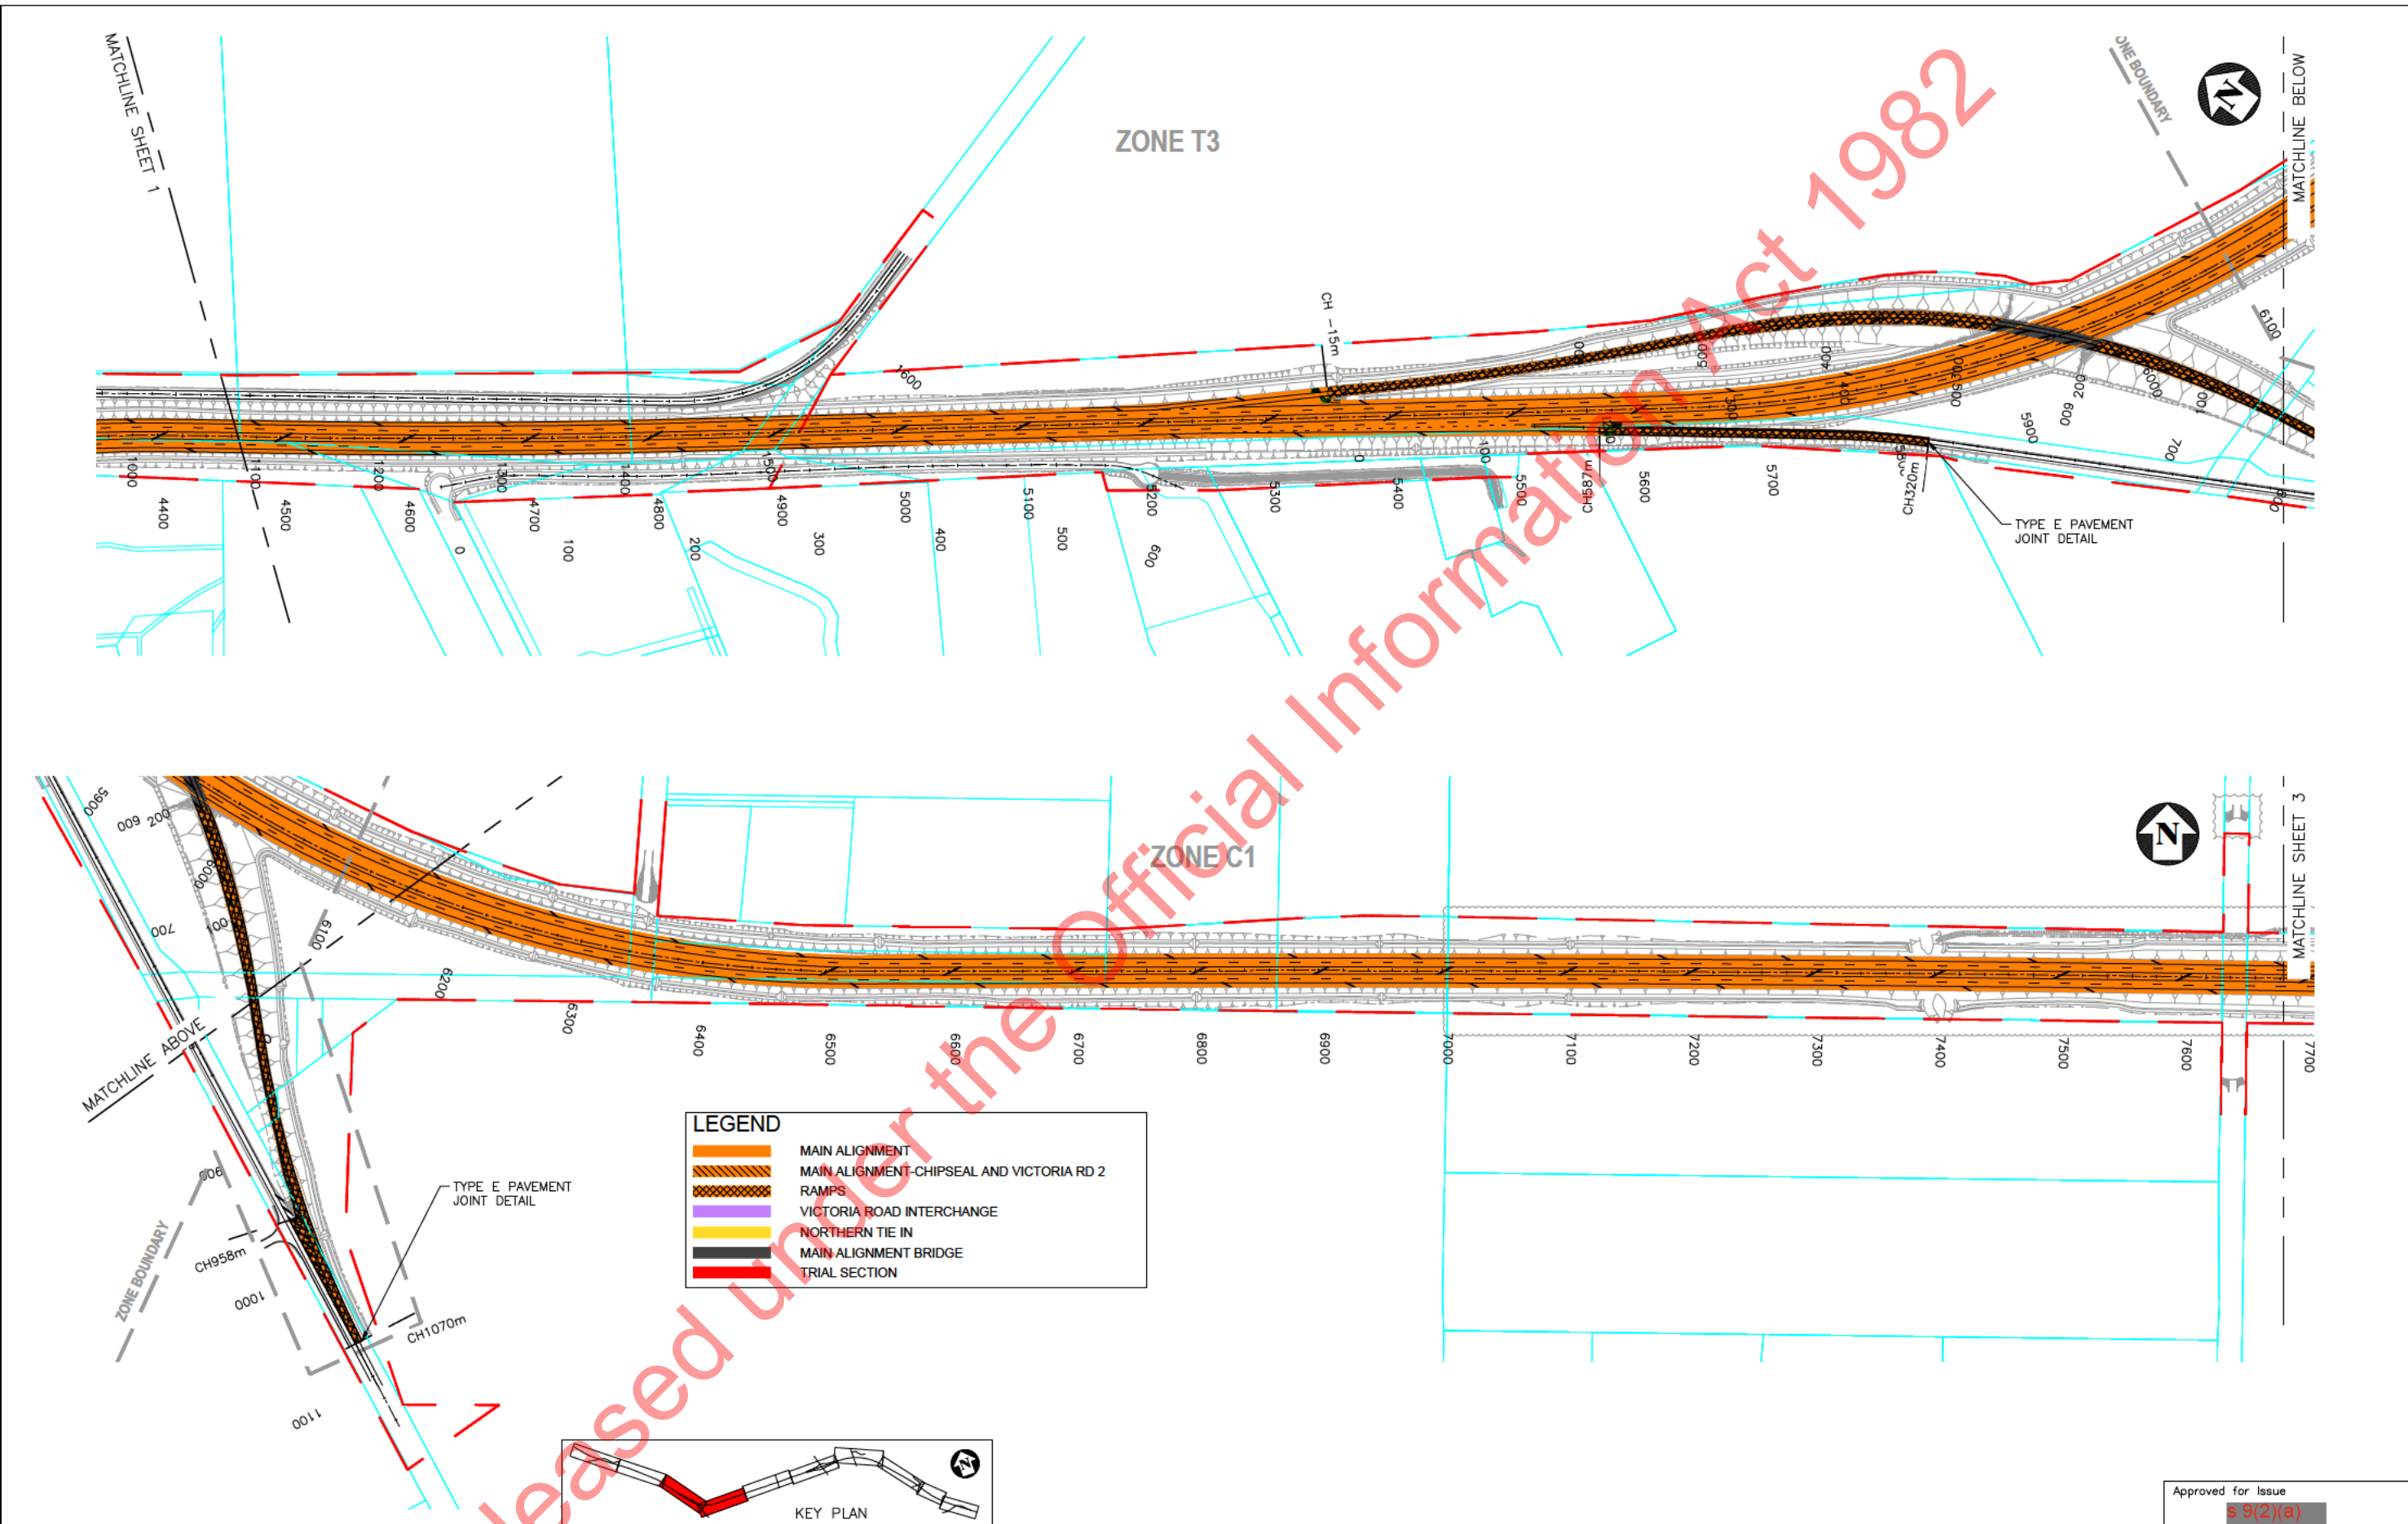

										Tob 102		 HEB Construction				 NZ TRANSPORT AGENCY WAIKATO MOTAHU		WAIKATO EXPRESSWAY: TAMAHERE TO CAMBRIDGE SECTION																																																																																																																																																																																																																																																																																																																																																																																																																																																																																																																																																																																																																																																																																																																																																																																																																																																																																																																																																																																																																																																																																																																																																																																																																																																																																																																																																																												
										Scales		1:2500 A1 1:5000 A3		   		PAVEMENT TYPES EXPRESSWAY AND RAMPS SHEET 2 OF 5		Status AS-BUILT																																																																																																																																																																																																																																																																																																																																																																																																																																																																																																																																																																																																																																																																																																																																																																																																																																																																																																																																																																																																																																																																																																																																																																																																																																																																																																																																																																												
										Original Size A1								Drawing Number C-115-102		Revision 01																																																																																																																																																																																																																																																																																																																																																																																																																																																																																																																																																																																																																																																																																																																																																																																																																																																																																																																																																																																																																																																																																																																																																																																																																																																																																																																																																																										
01	AS--BUILT AMENDED																																																																																																																																																																																																																																																																																																																																																																																																																																																																																																																																																																																																																																																																																																																																																																																																																																																																																																																																																																																																																																																																																																																																																																																																																																																																																																																																																																																													

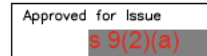
[illegible][illegible]

Tab	103
Scales	1:2500 A1 1:5000 A3
Original Size	A1





Drawing Number	Re
C-115-103	

This design is based on generally accepted practices and standards at the time it was prepared. No other warranty, expressed or implied, is made. It is prepared in accordance with the scope of work and for the purpose outlined in the contract dated 27 Sept 2012. No responsibility is accepted for use of any part of this design in any other context or for any other purpose. URS accepts no liability for the use of this drawing where it has been provided in electronic format, nor for any changes made to it following its issue. URS considers the printed version to be binding. A hard copy of this drawing is held on file by URS and may be provided if requested.

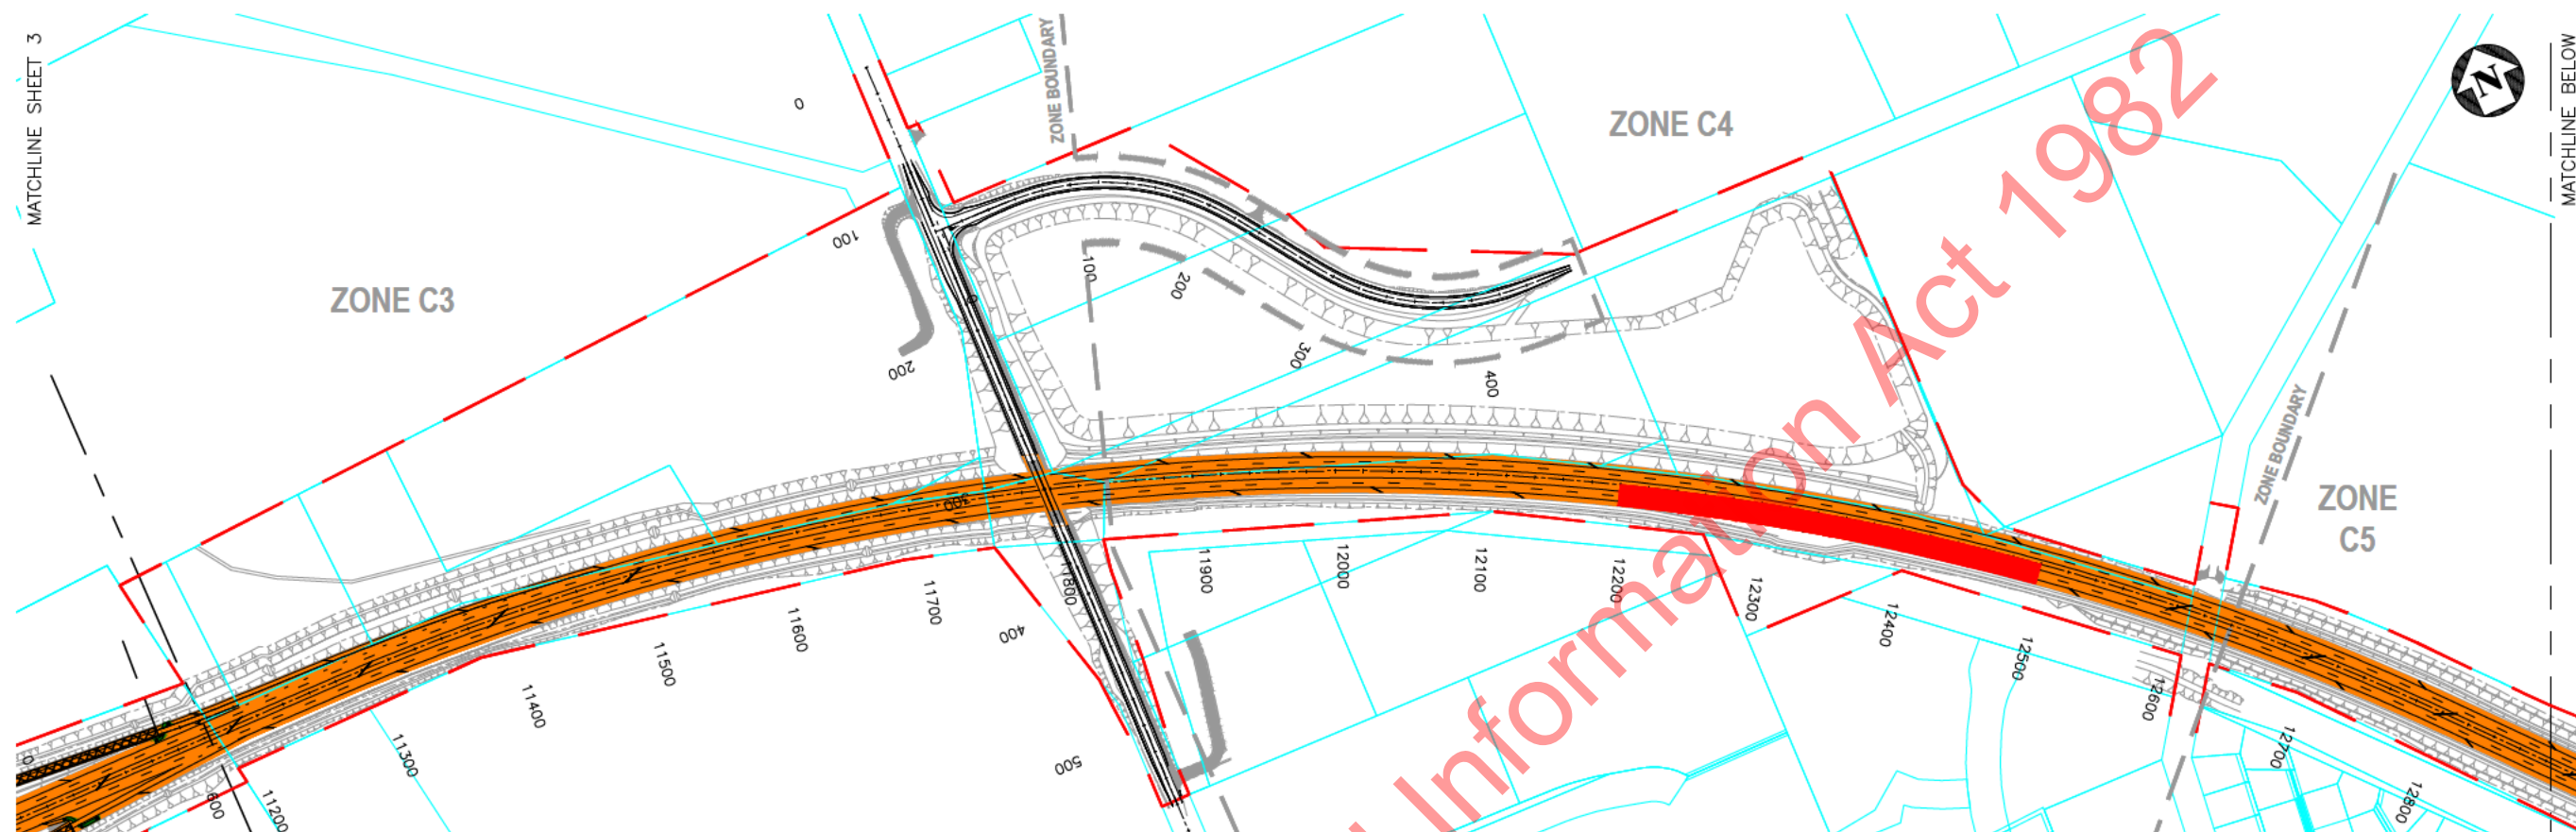

LEGEND

- MAIN ALIGNMENT
- MAIN ALIGNMENT-CHIPSEAL AND VICTORIA RD 2
- RAMPS
- VICTORIA ROAD INTERCHANGE
- NORTHERN TIE IN
- MAIN ALIGNMENT BRIDGE
- TRIAL SECTION

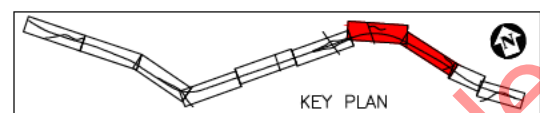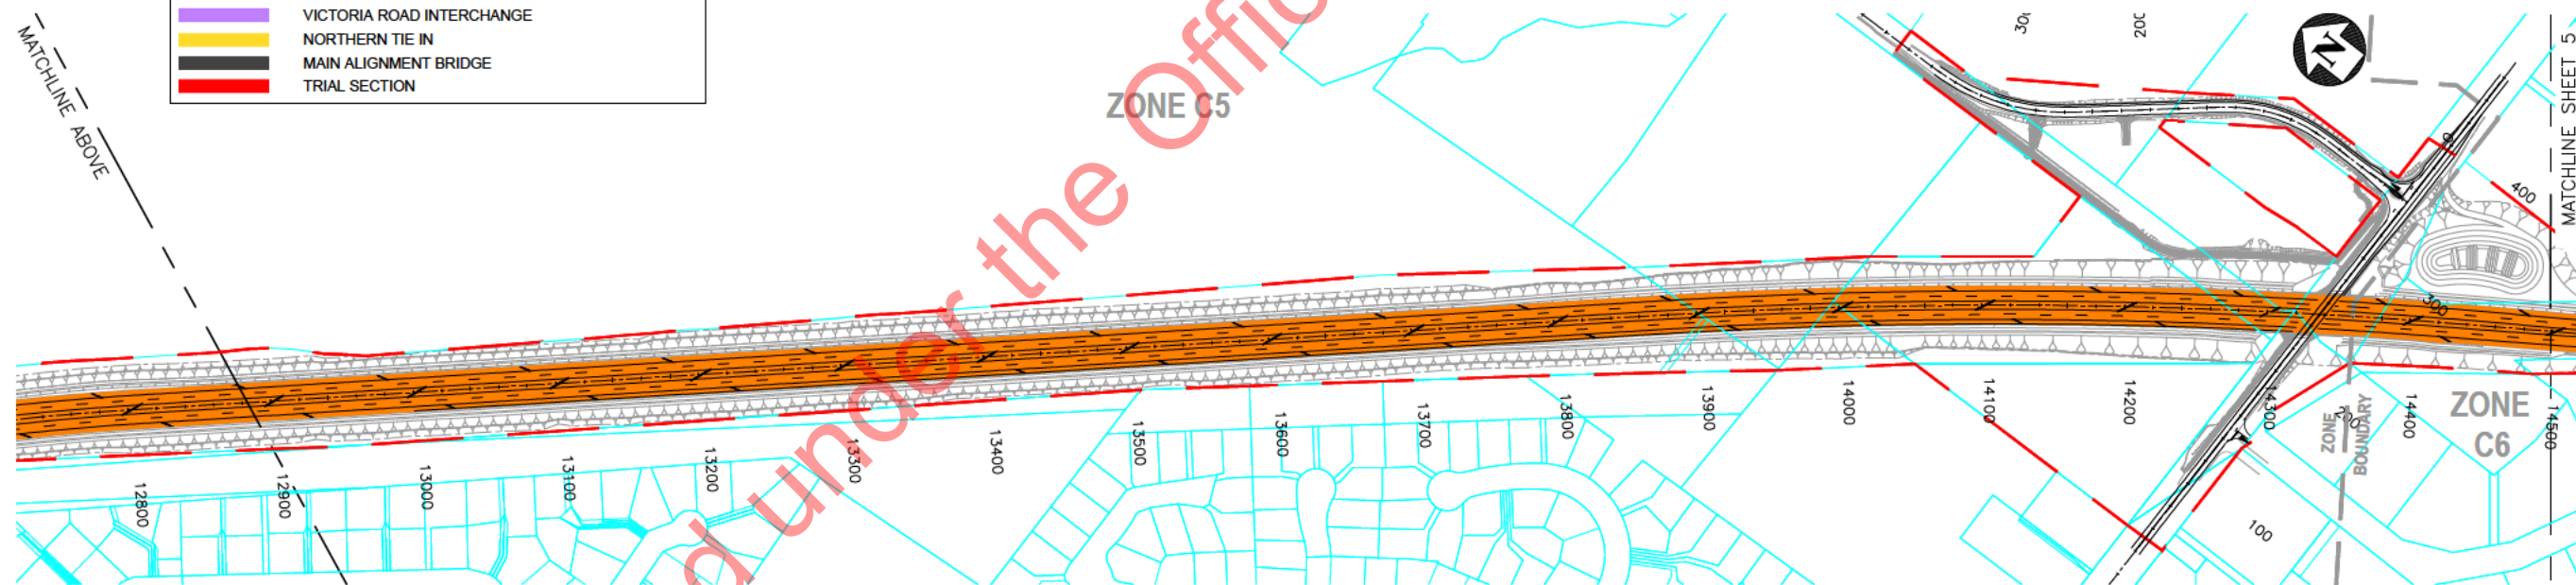


Rev	Revision Description	Drawn	Checked	Designed	Design Checked	Approved	Date
01	AS-BUILT AMENDED						12.06.17
AB	AS-BUILT						16.09.15


Tob	104
Scales	1:2500 A1 1:5000 A3
Original Size	A1

WAIKATO EXPRESSWAY: TAMAHERE TO CAMBRIDGE SECTION		
PAVEMENT TYPES EXPRESSWAY AND RAMPS SHEET 4 OF 5		Status AS-BUILT
Drawing Number C-115-104		Revision 01

This design is based on generally accepted practices and standards at the time it was prepared. No other warranty, expressed or implied, is made. It is prepared in accordance with the scope of work and for the purpose outlined in the contract dated 27 Sept 2012. No responsibility is accepted for use of any part of this design in any other context or for any other purpose. URS accepts no liability for the use of this drawing where it has been provided in electronic format, nor for any changes made to it following its issue. URS considers the printed version to be binding. A hard copy of this drawing is held on file by URS and may be provided if requested.

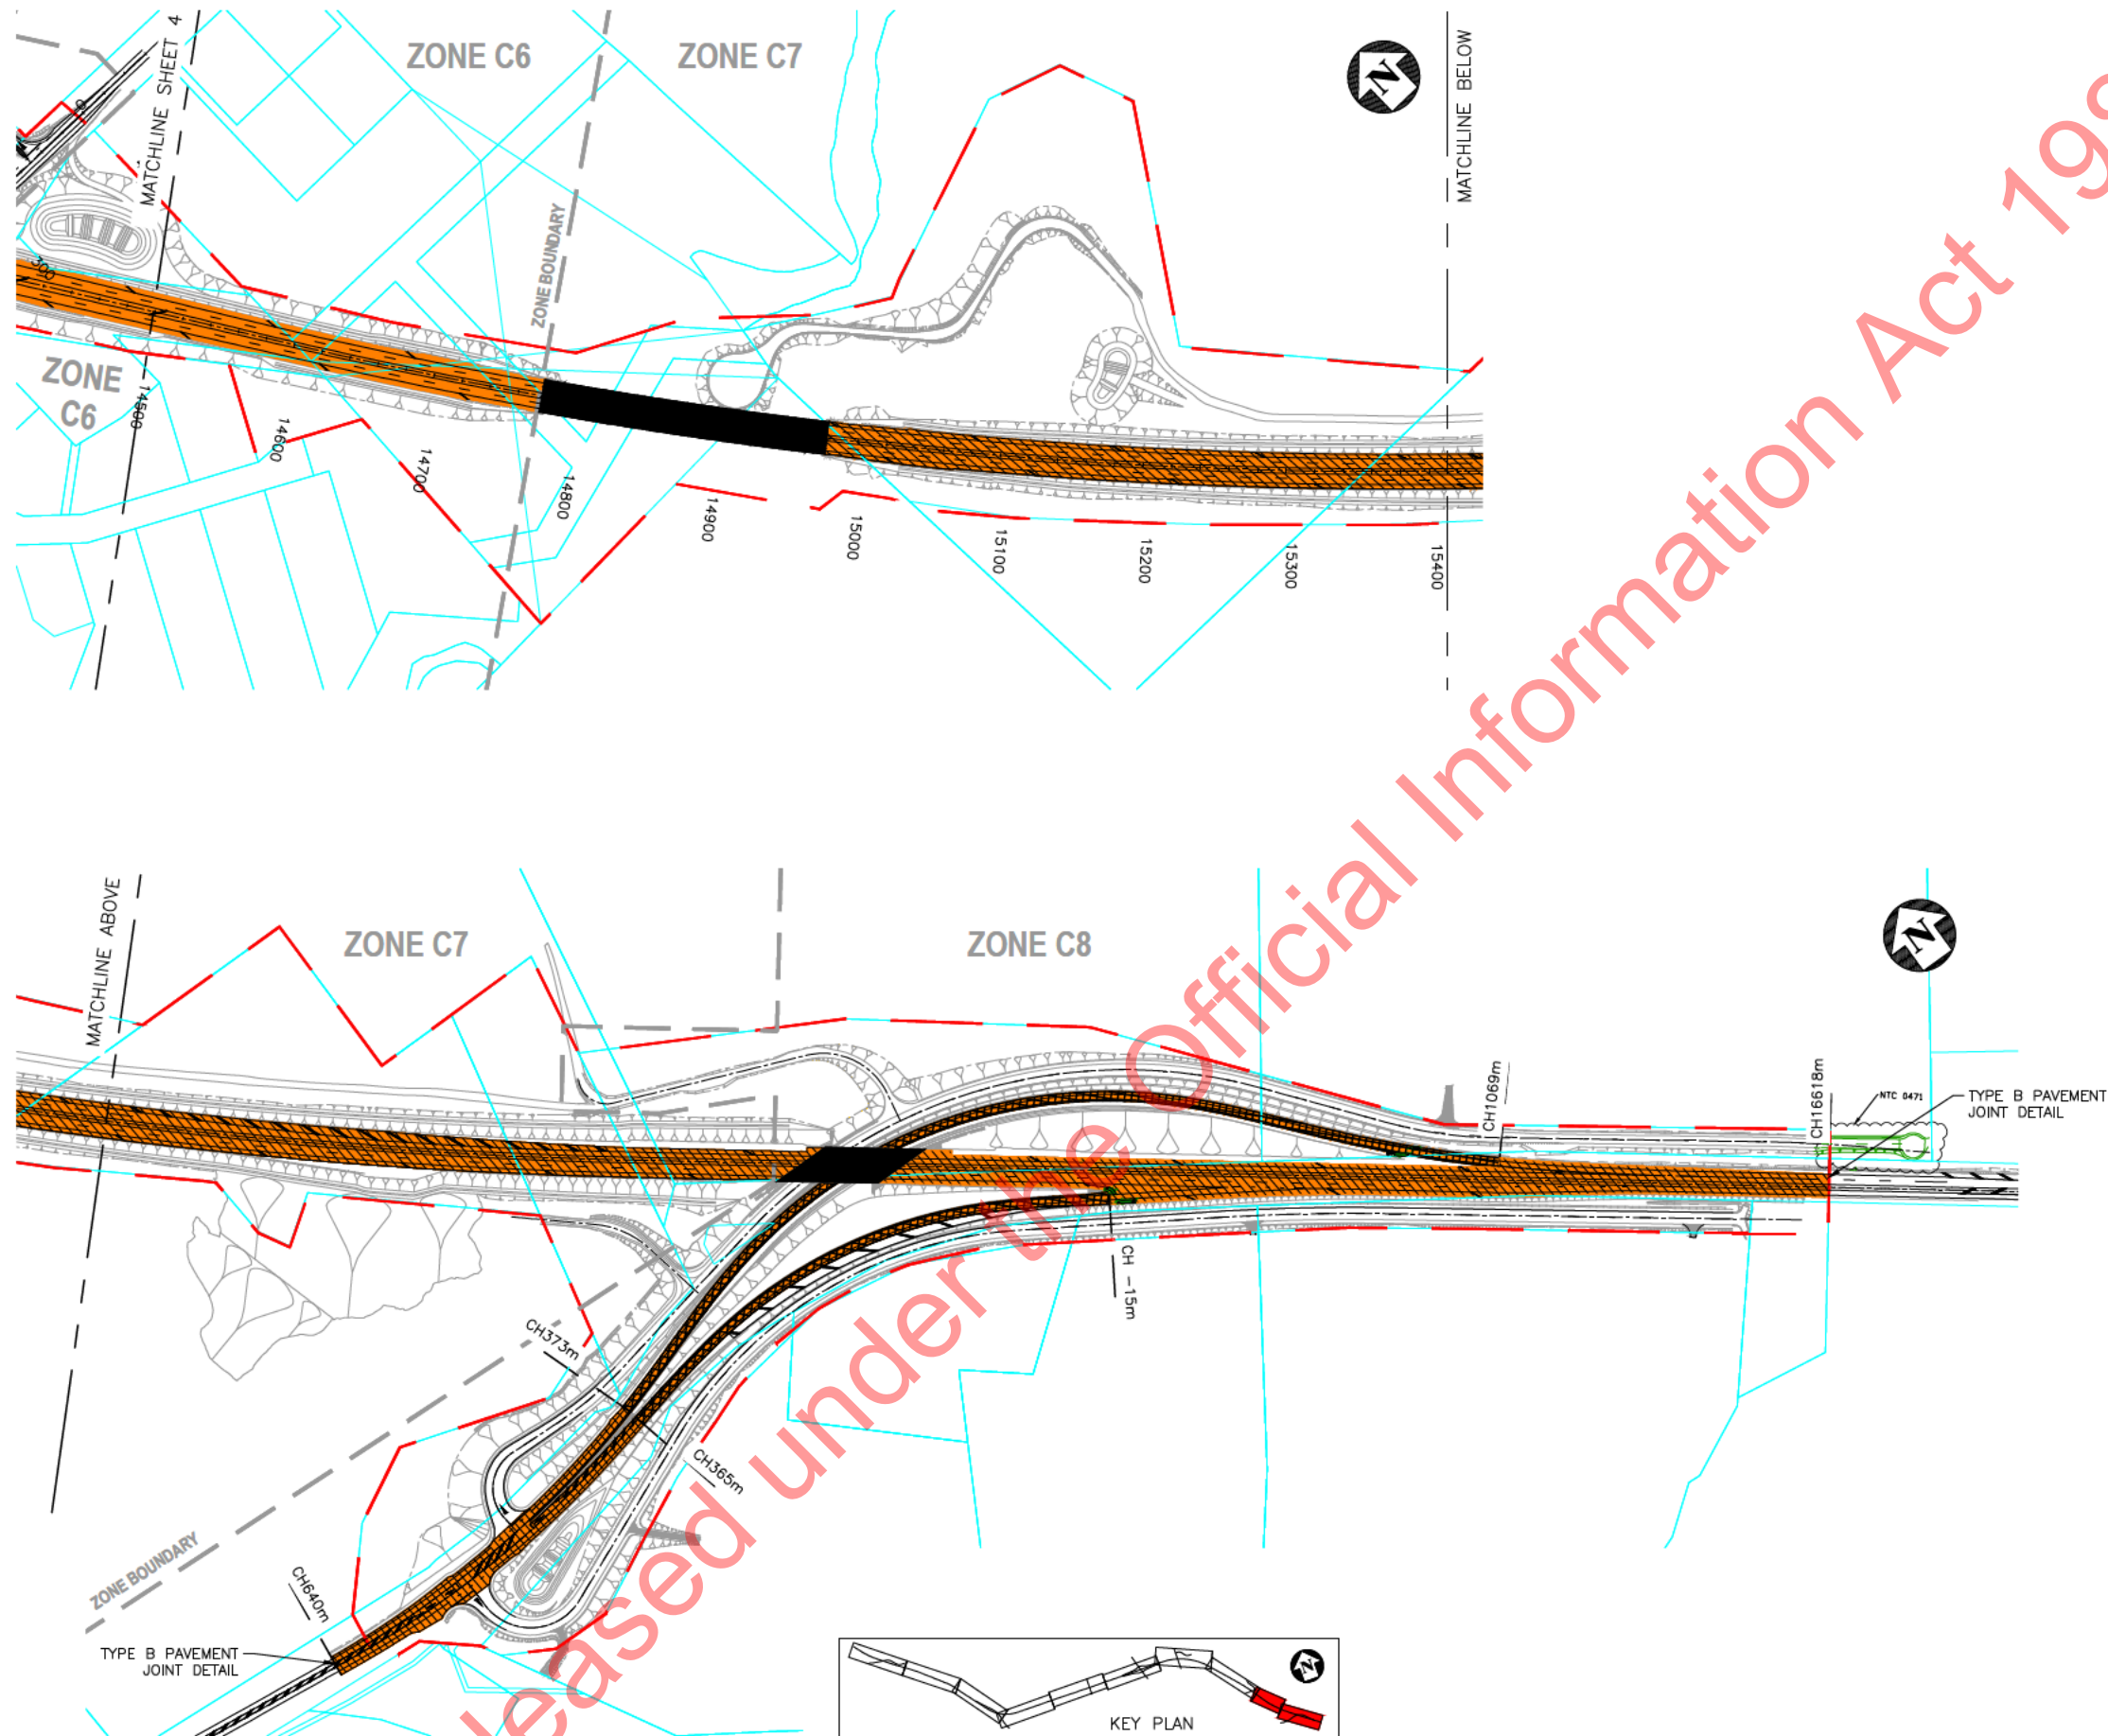

LEGEND	
	MAIN ALIGNMENT
	MAIN ALIGNMENT-CHIPSEAL AND VICTORIA RD 2
	RAMPS
	VICTORIA ROAD INTERCHANGE
	NORTHERN TIE IN
	MAIN ALIGNMENT BRIDGE
	TRIAL SECTION

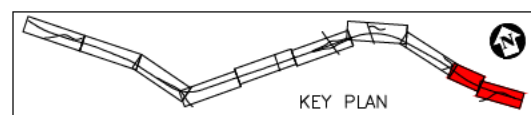

Approved for Issue
S 9(2)(a)

Rev	Revision Description	Drawn	Checked	Designed	Design Checked	Approved	Date
01	AS-BUILT AMENDED					S 9(2)(a)	12.06.17
02	AS-BUILT					S 9(2)(a)	16.09.15

Tob	105
Scales	1:2500 A1 1:5000 A3
Original Size	A1

WAIKATO EXPRESSWAY: TAMAHERE TO CAMBRIDGE SECTION		
PAVEMENT TYPES EXPRESSWAY AND RAMPS SHEET 5 OF 5		Status AS-BUILT
Drawing Number C-115-105	Revision 01	