
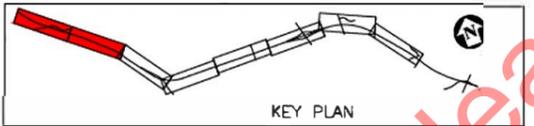
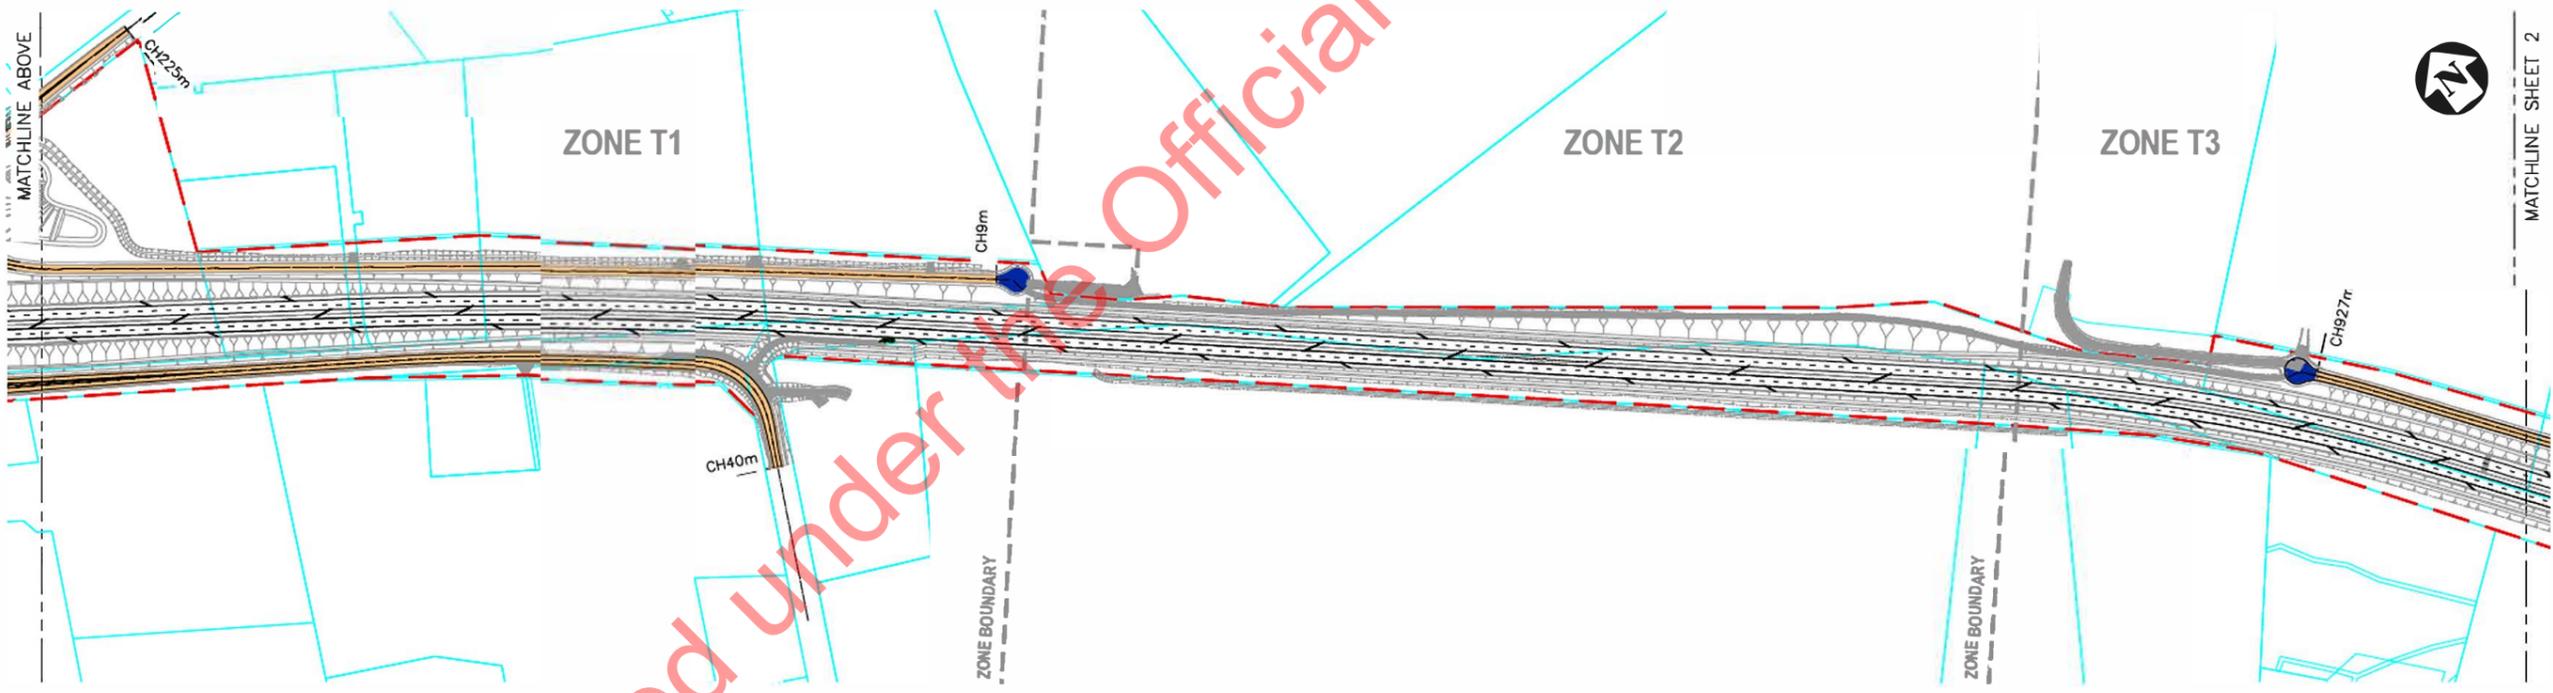


This design is based on generally accepted practices and standards at the time it was prepared. No other warranty, expressed or implied, is made. It is prepared in accordance with the scope of work and for the purpose outlined in the contract dated 27 Sept 2012. No responsibility is accepted for use of any part of this design in any other context or for any other purpose. URS accepts no liability for the use of this drawing where it has been provided in electronic format, nor for any changes made to it following its issue. URS considers the printed version to be binding. A hard copy of this drawing is held on file by URS and may be provided if requested.

LEGEND	
	SMA HIGH PSV
	DG7 LOW PSV
	CHIP SEAL LOW PSV
	AC10 LOW PSV

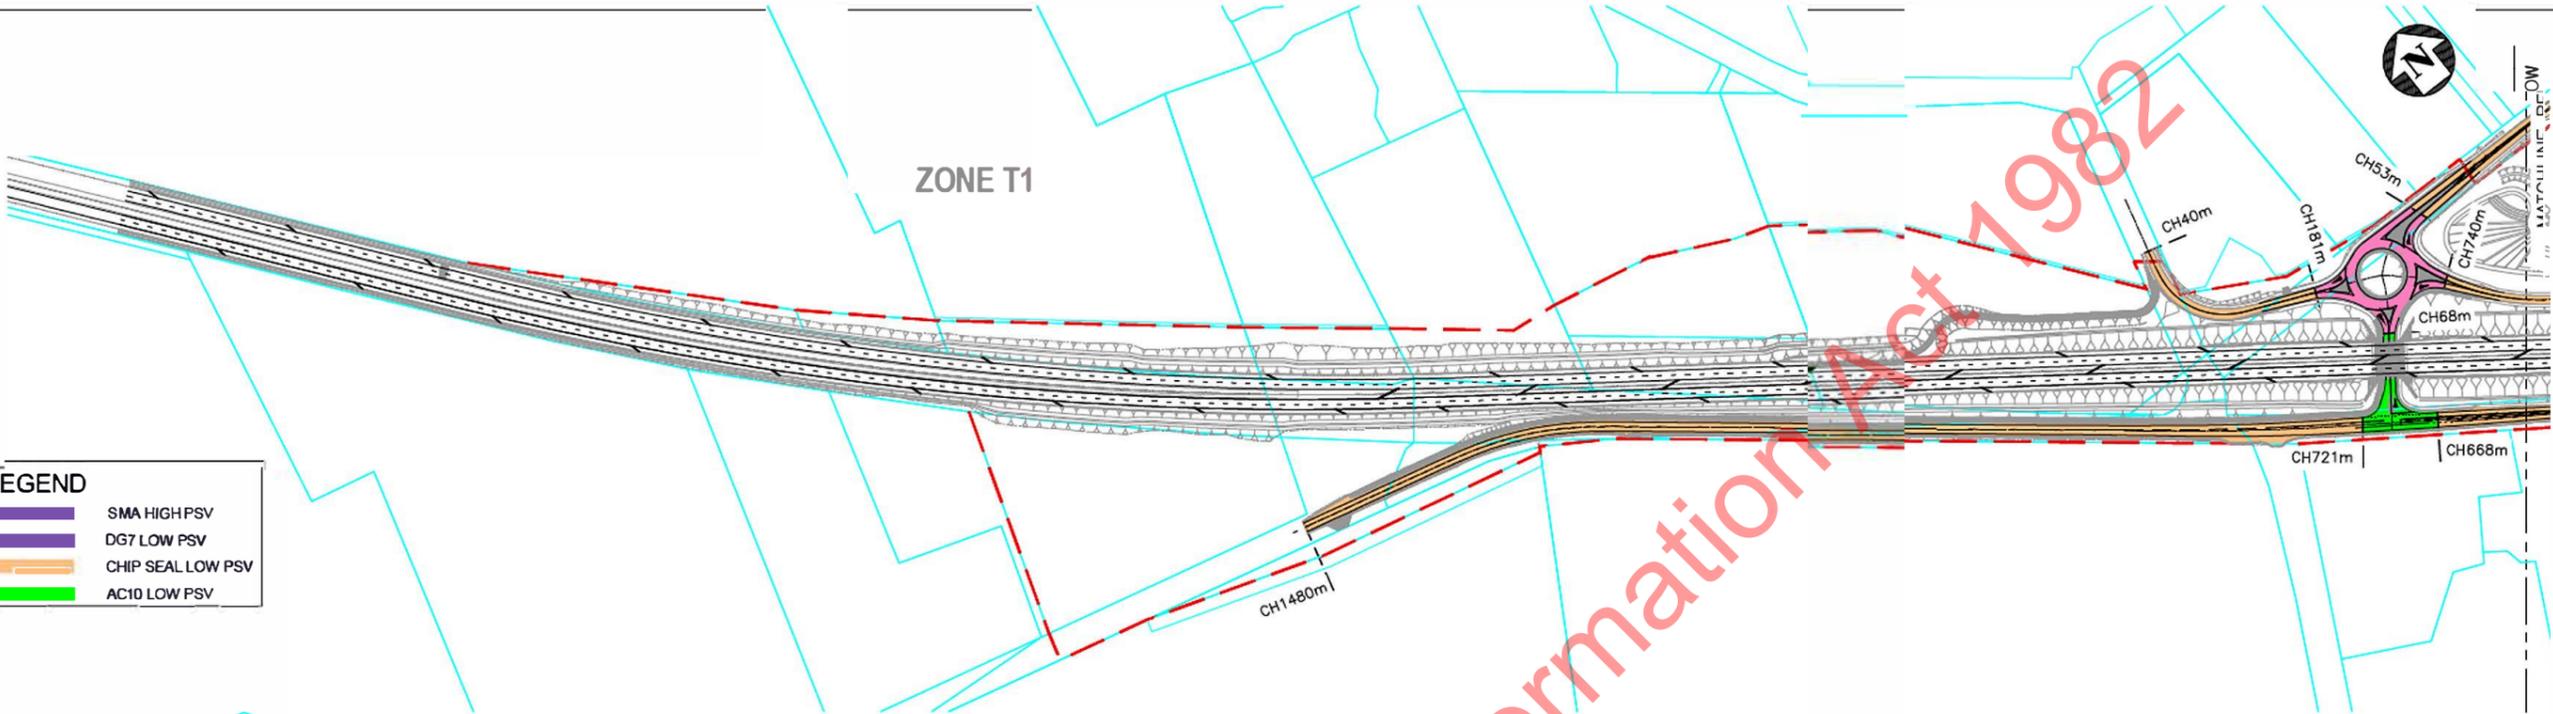

AB	AS-BUILT	5 9(2)(a)	5 9(2)(a)	03.11.15			
Rev	Revision Description	Drawn	Checked	Designed	Design Checked	Approved	Date

Tab	011
Scales	1:2500 A1 1:5000 A3
Original Size	A1












Approved for Issue	
WAIKATO EXPRESSWAY: TAMAHERE TO CAMBRIDGE SECTION	
SURFACING PLAN LOCAL ROADS SHEET 1 OF 5	Status AS-BUILT
Drawing Number C-115-011	Revision AB

This design is based on generally accepted practices and standards at the time it was prepared. No other warranty, expressed or implied, is made. It is prepared in accordance with the scope of work and for the purpose outlined in the contract dated 27 Sept 2012. No responsibility is accepted for use of any part of this design in any other context or for any other purpose. URS accepts no liability for the use of this drawing where it has been provided in electronic format, nor for any changes made to it following its issue. URS considers the printed version to be binding. A hard copy of this drawing is held on file by URS and may be provided if requested.

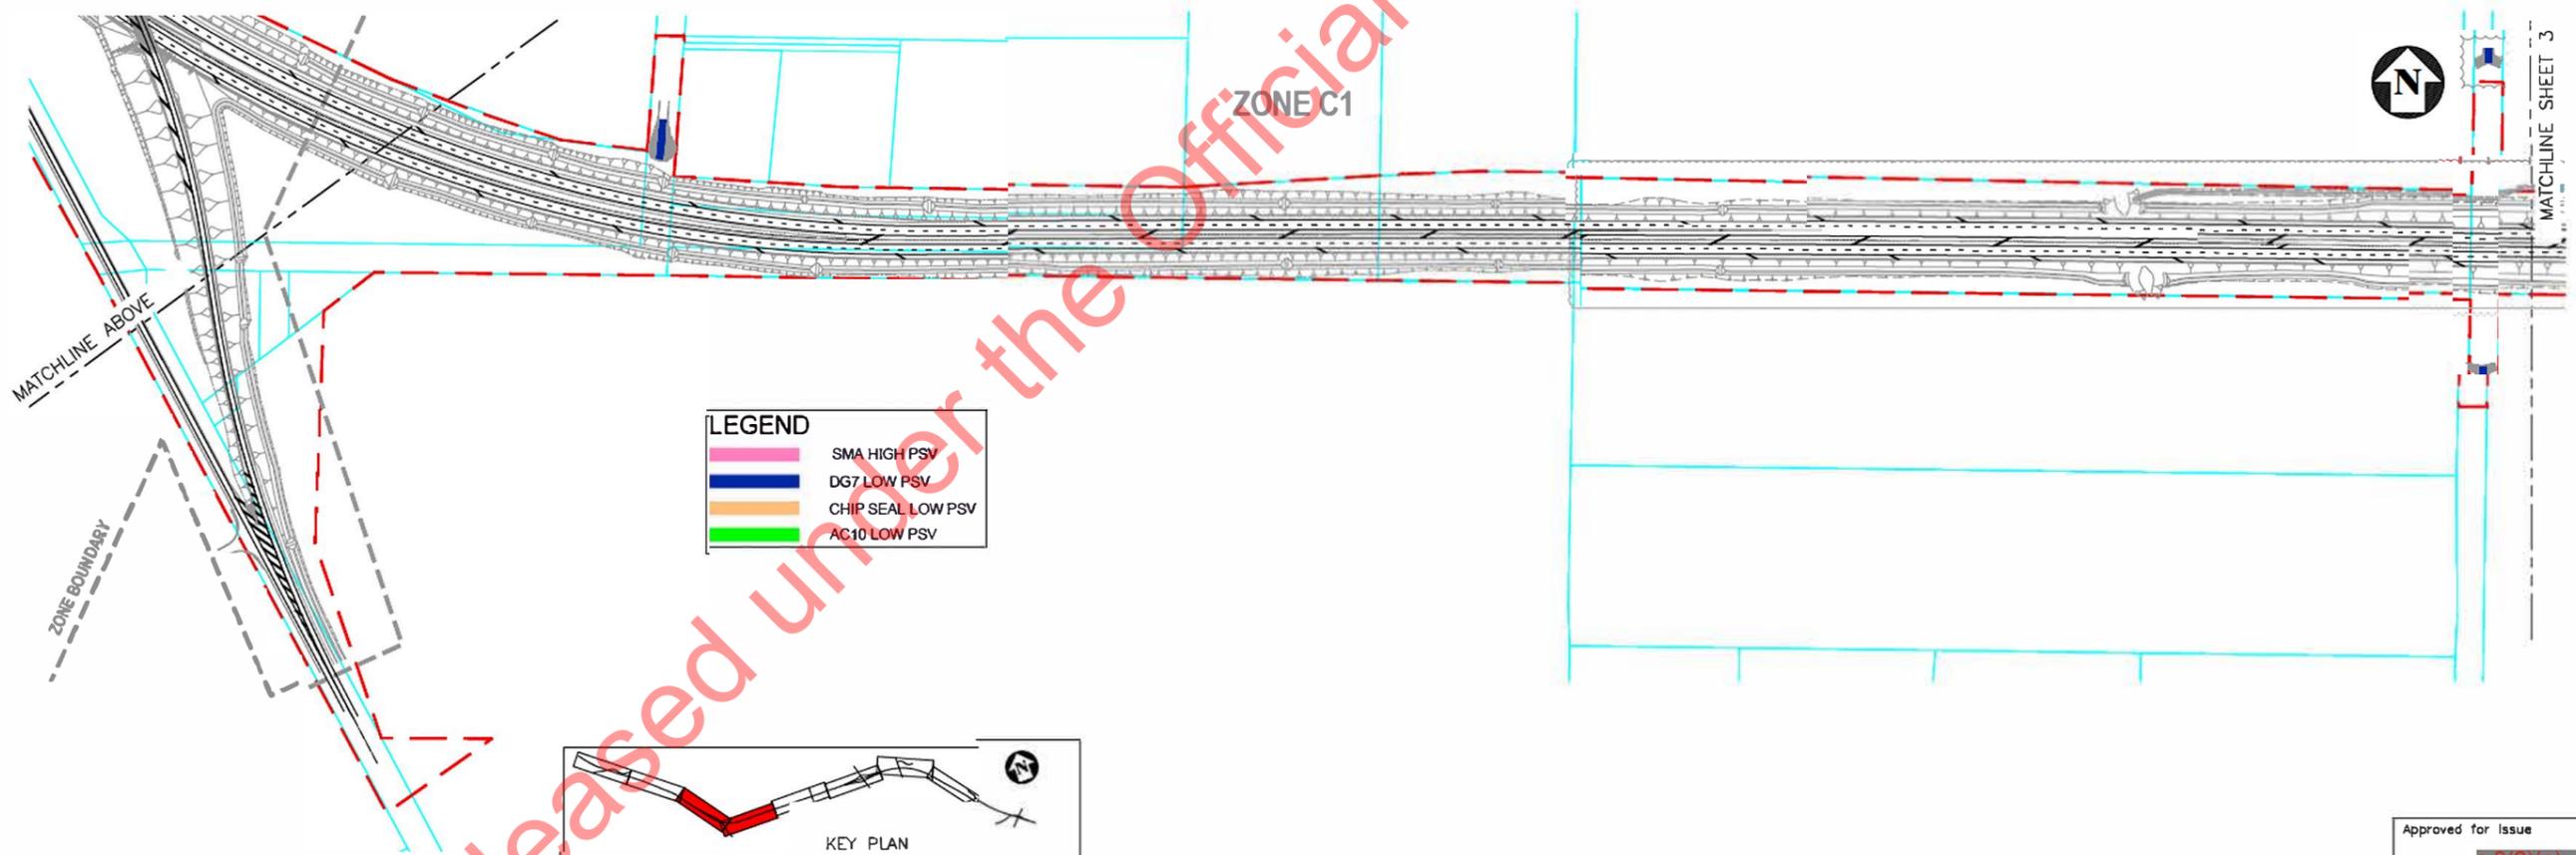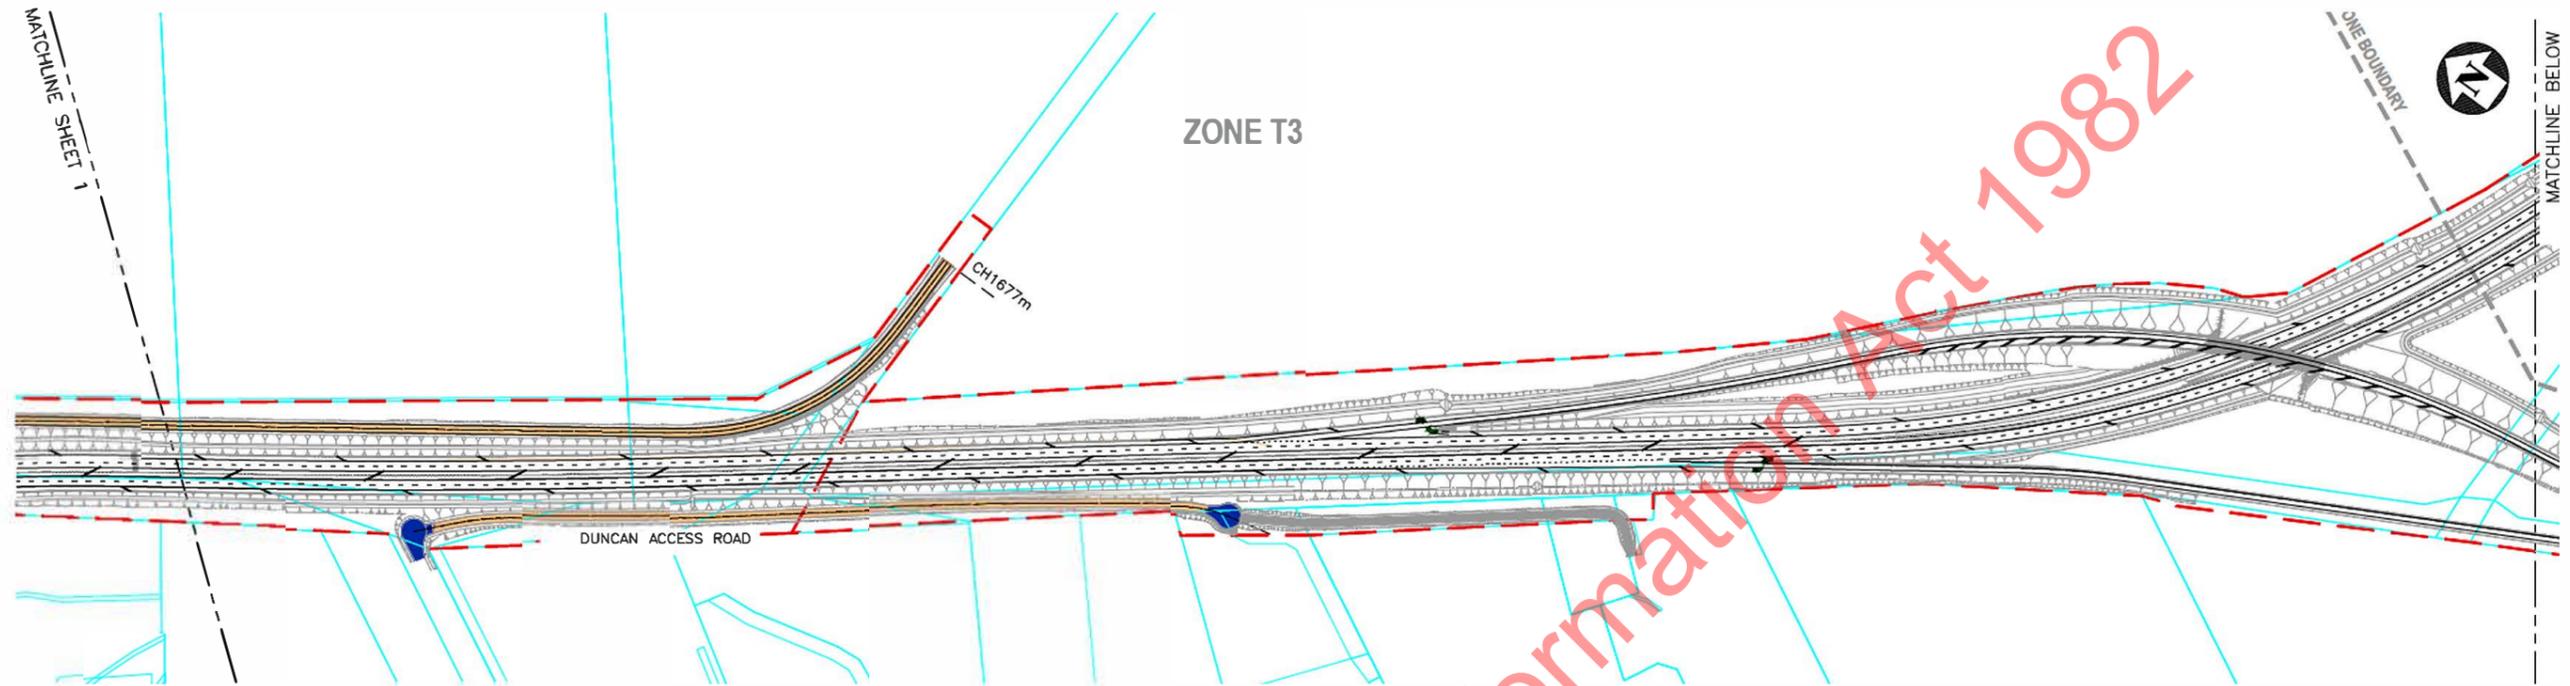


AB	AS-BUILT	s 9(2)(a)	s 9(2)(a)	03.11.15	Original Size	A1
Rev	Revision Description	Drawn	Designed	Design	Approved	Date

Tob	012
Scales	1:2500 A1 1:5000 A3

Approved for Issue	
s 9(2)(a)	
WAIKATO EXPRESSWAY: TAMAHERE TO CAMBRIDGE SECTION	
SURFACING PLAN	Status AS-BUILT
LOCAL ROADS	Drawing Number C-115-012
SHEET 2 OF 5	Revision AB

This design is based on generally accepted practices and standards of the time it was prepared. No other warranty, expressed or implied, is made. It is prepared in accordance with the scope of work and for the purpose outlined in the contract dated 27 Sept 2012. No responsibility is accepted for use of any part of this design in any other context or for any other purpose. URS accepts no liability for the use of this drawing where it has been provided in electronic format, nor for any changes made to it following its issue. URS considers the printed version to be binding. A hard copy of this drawing is held on file by URS and may be provided if requested.

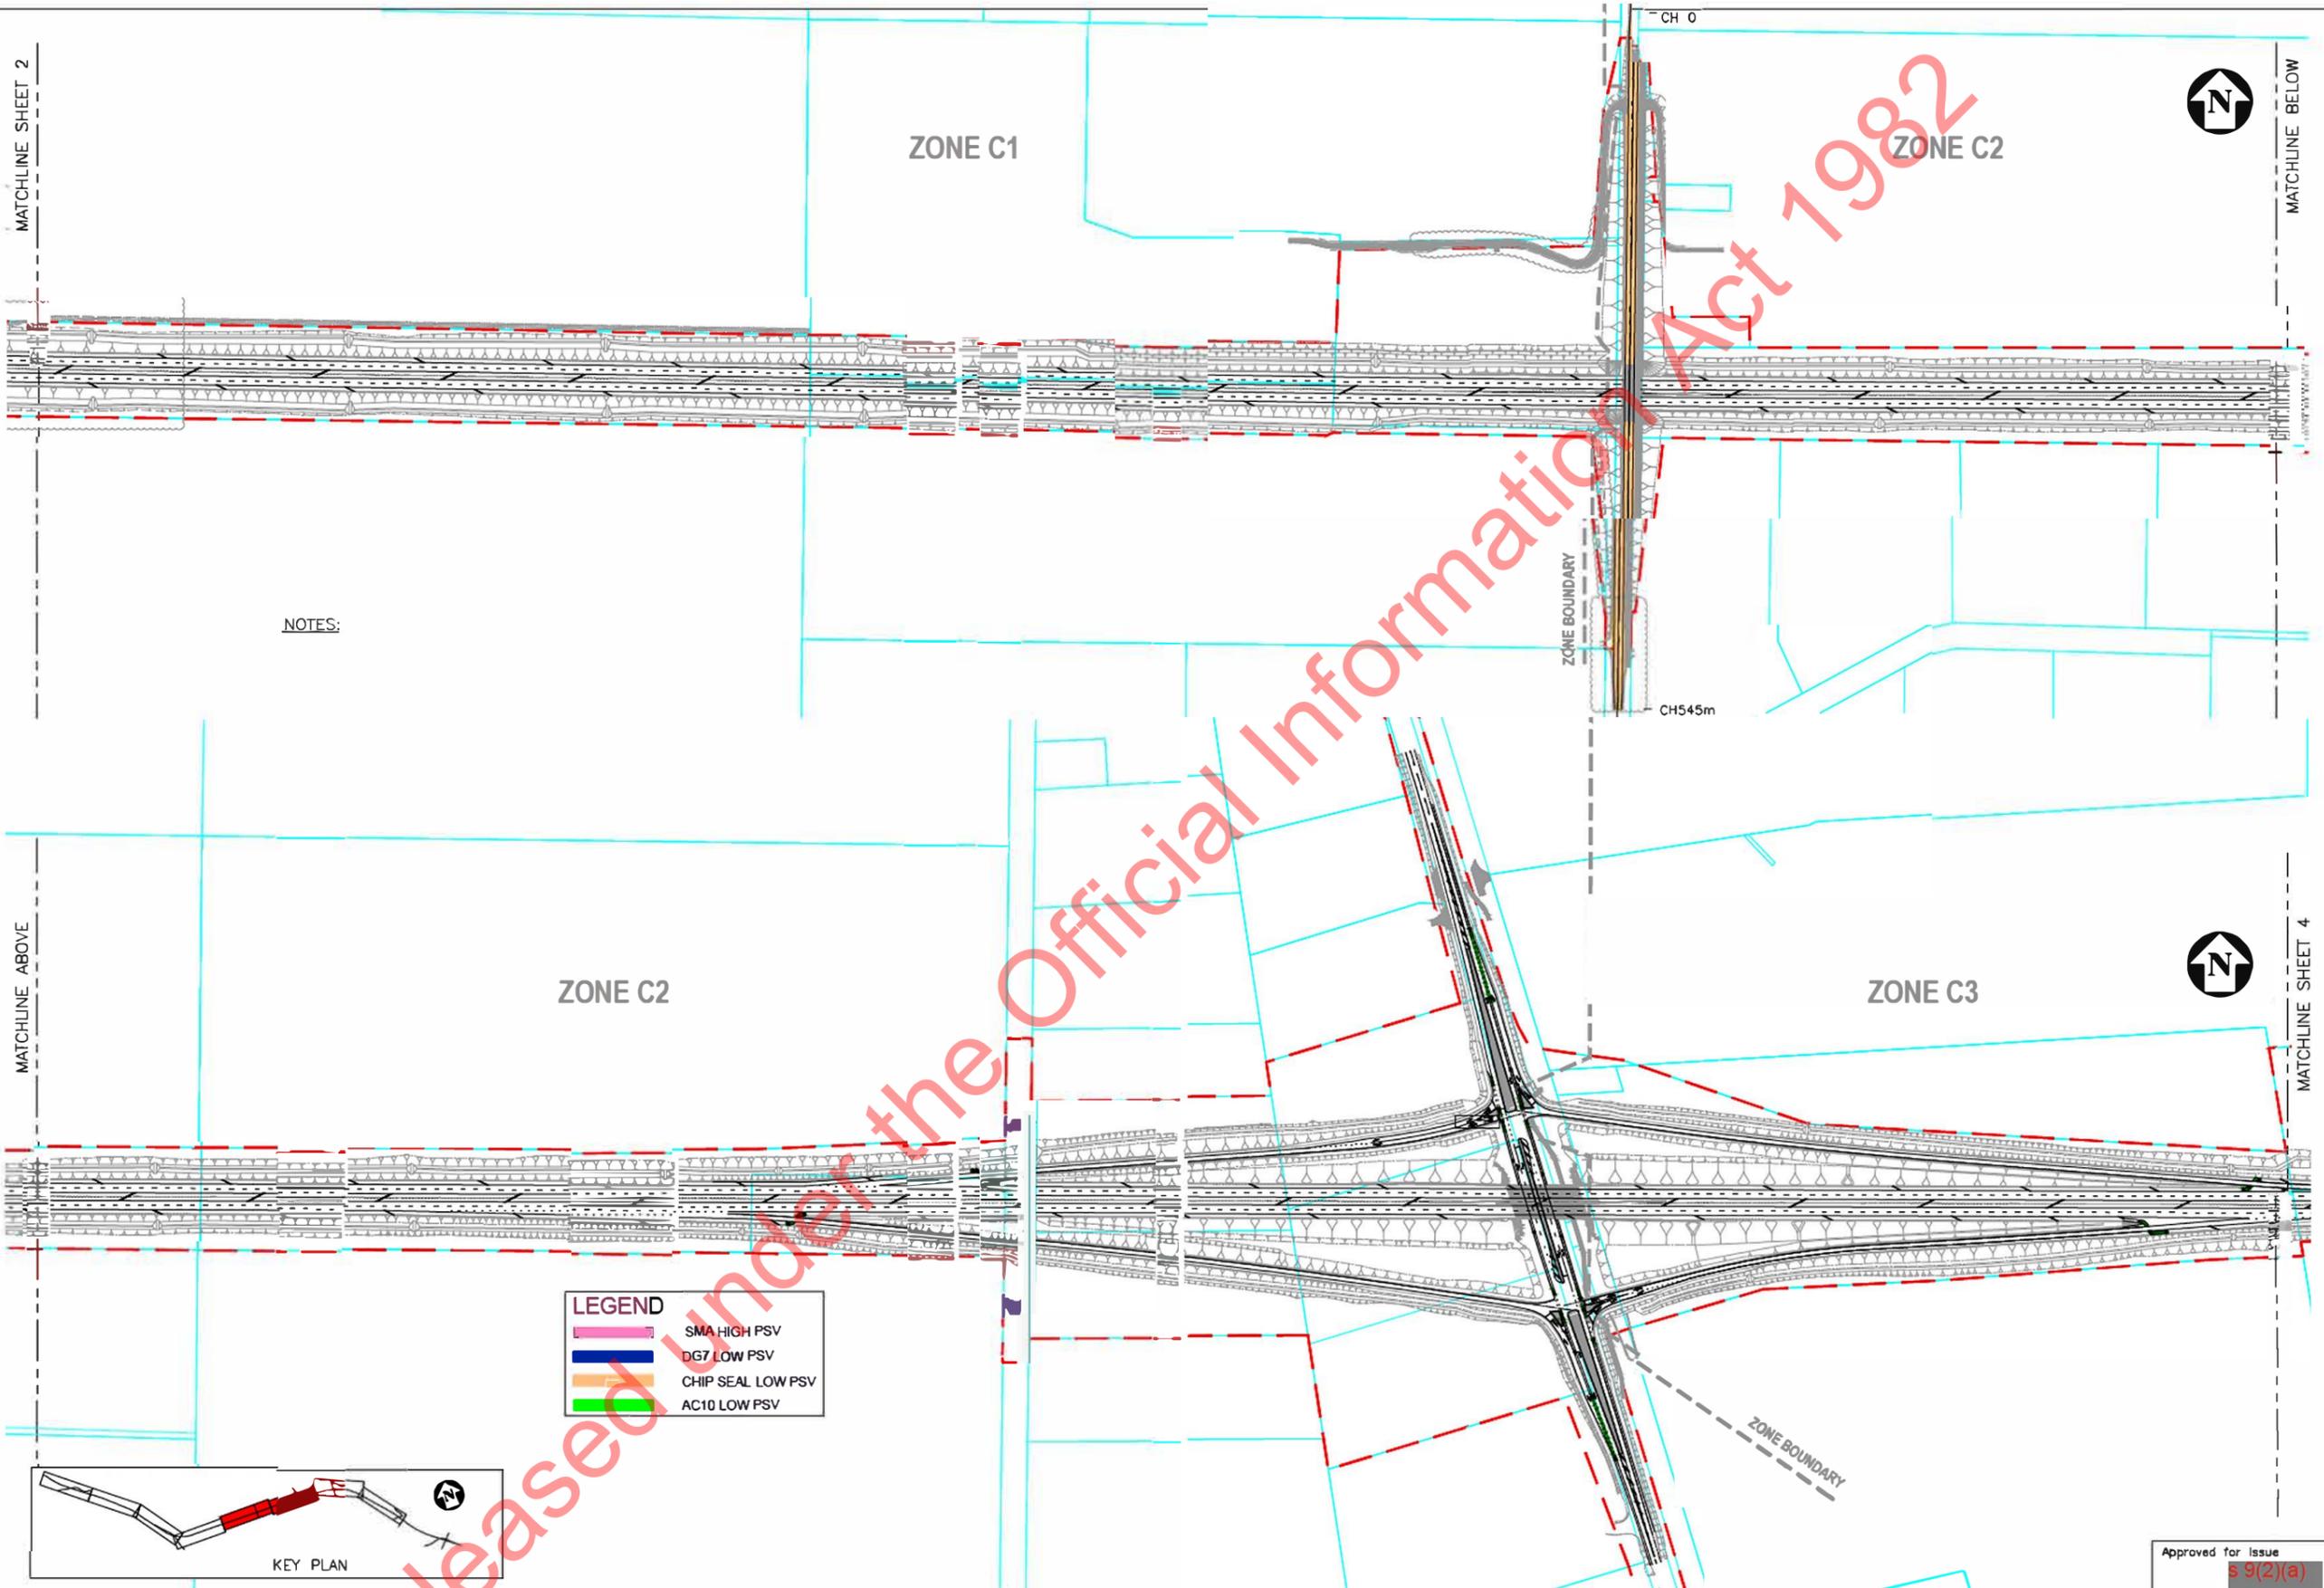

Released under the Official Information Act 1982

Tab	013
Scales	1:2500 A1 1:5000 A3
Original Size	A1
Drawn	§ 9(2)(a)
Checked	§ 9(2)(a)
Designed	§ 9(2)(a)
Design Checked	§ 9(2)(a)
Approved	§ 9(2)(a)
Date	03.11.15

Approved for Issue § 9(2)(a)

WAIKATO EXPRESSWAY: TAMAHERE TO CAMBRIDGE SECTION


**SURFACING PLAN
LOCAL ROADS
SHEET 3 OF 5**

Status **AS-BUILT**



Drawing Number **C-115-013**

Revision **AB**

This design is based on generally accepted practices and standards at the time it was prepared. No other warranty, expressed or implied, is made. It is prepared in accordance with the scope of work and for the purpose outlined in the contract dated 27 Sept 2012. No responsibility is accepted for use of any part of this design in any other context or for any other purpose. URS accepts no liability for the use of this drawing where it has been provided in electronic format, nor for any changes made to it following its issue. URS considers the printed version to be binding. A hard copy of this drawing is held on file by URS and may be provided if requested.

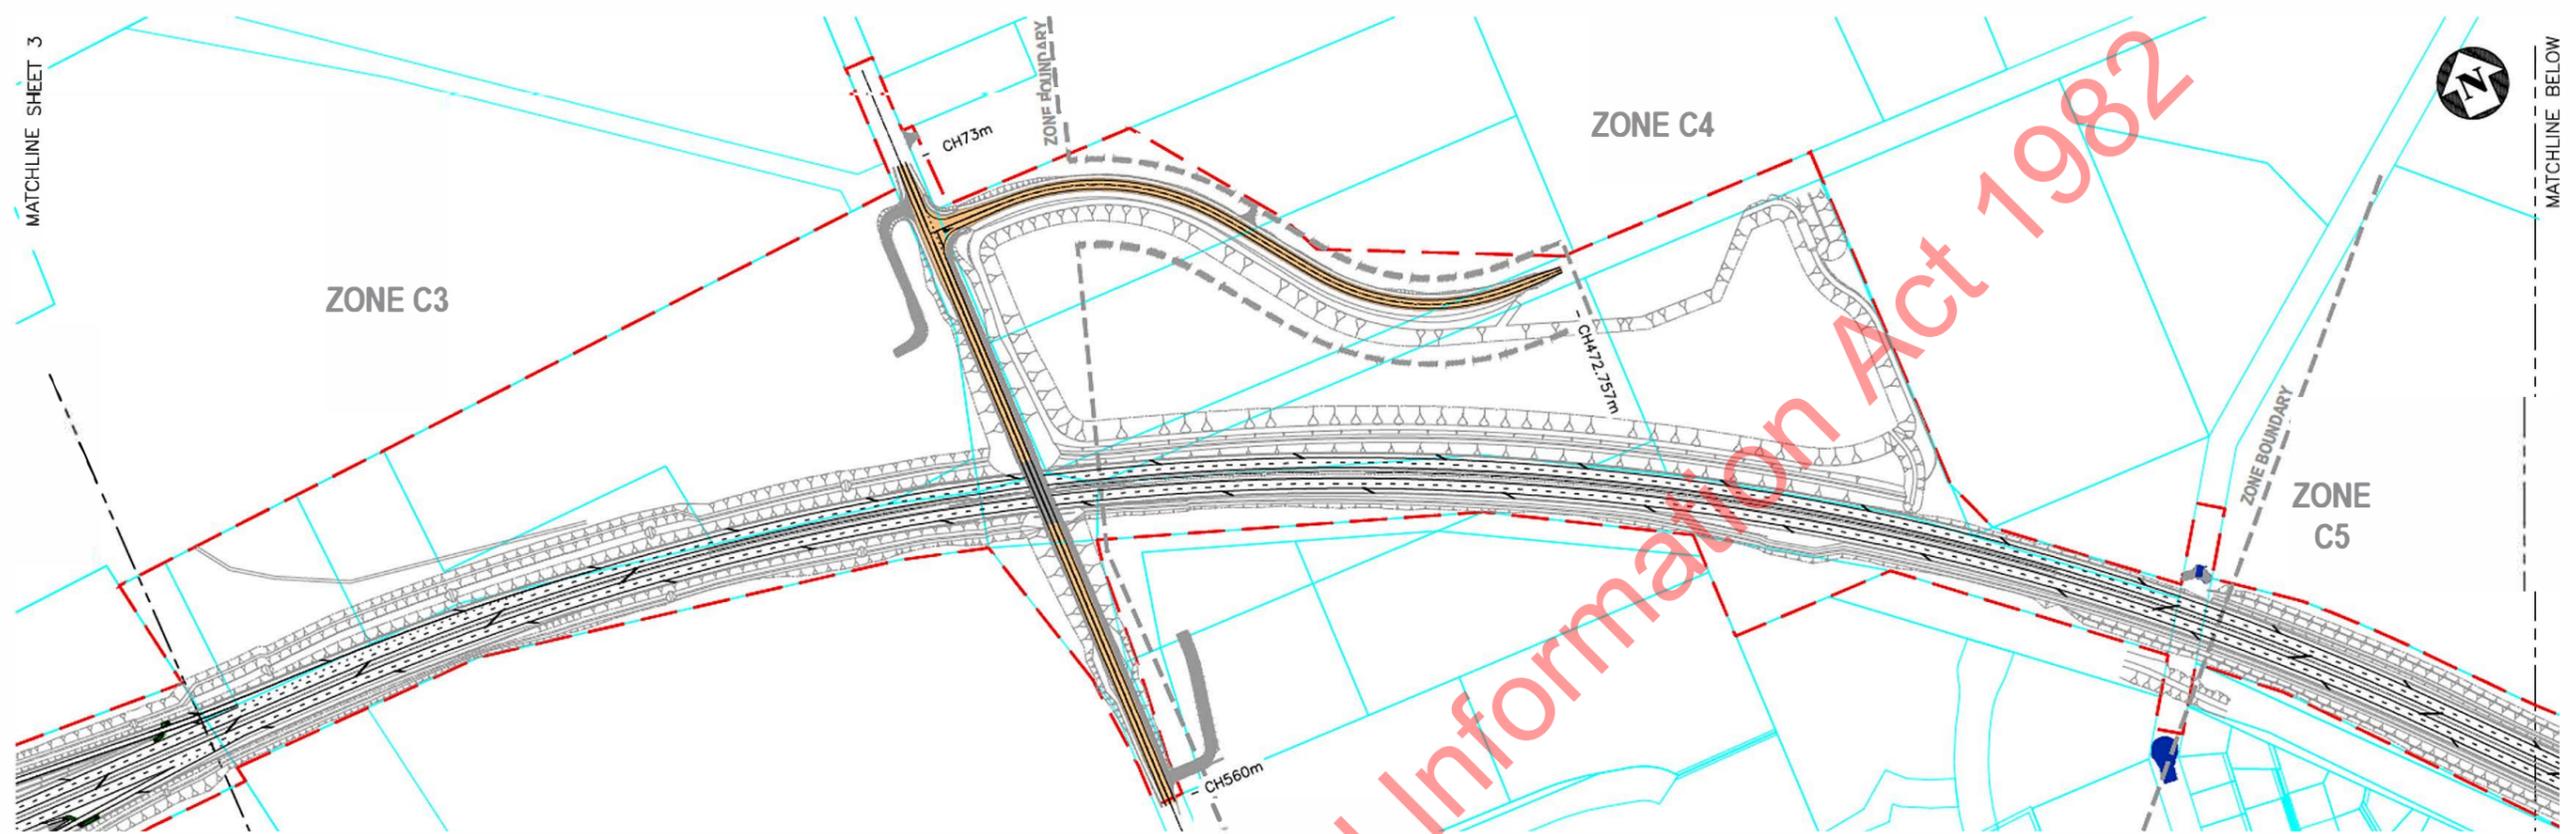


LEGEND	
	SMA HIGH PSV
	DG7 LOW PSV
	CHIP SEAL LOW PSV
	AC10 LOW PSV

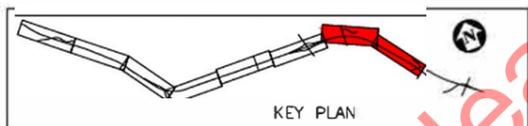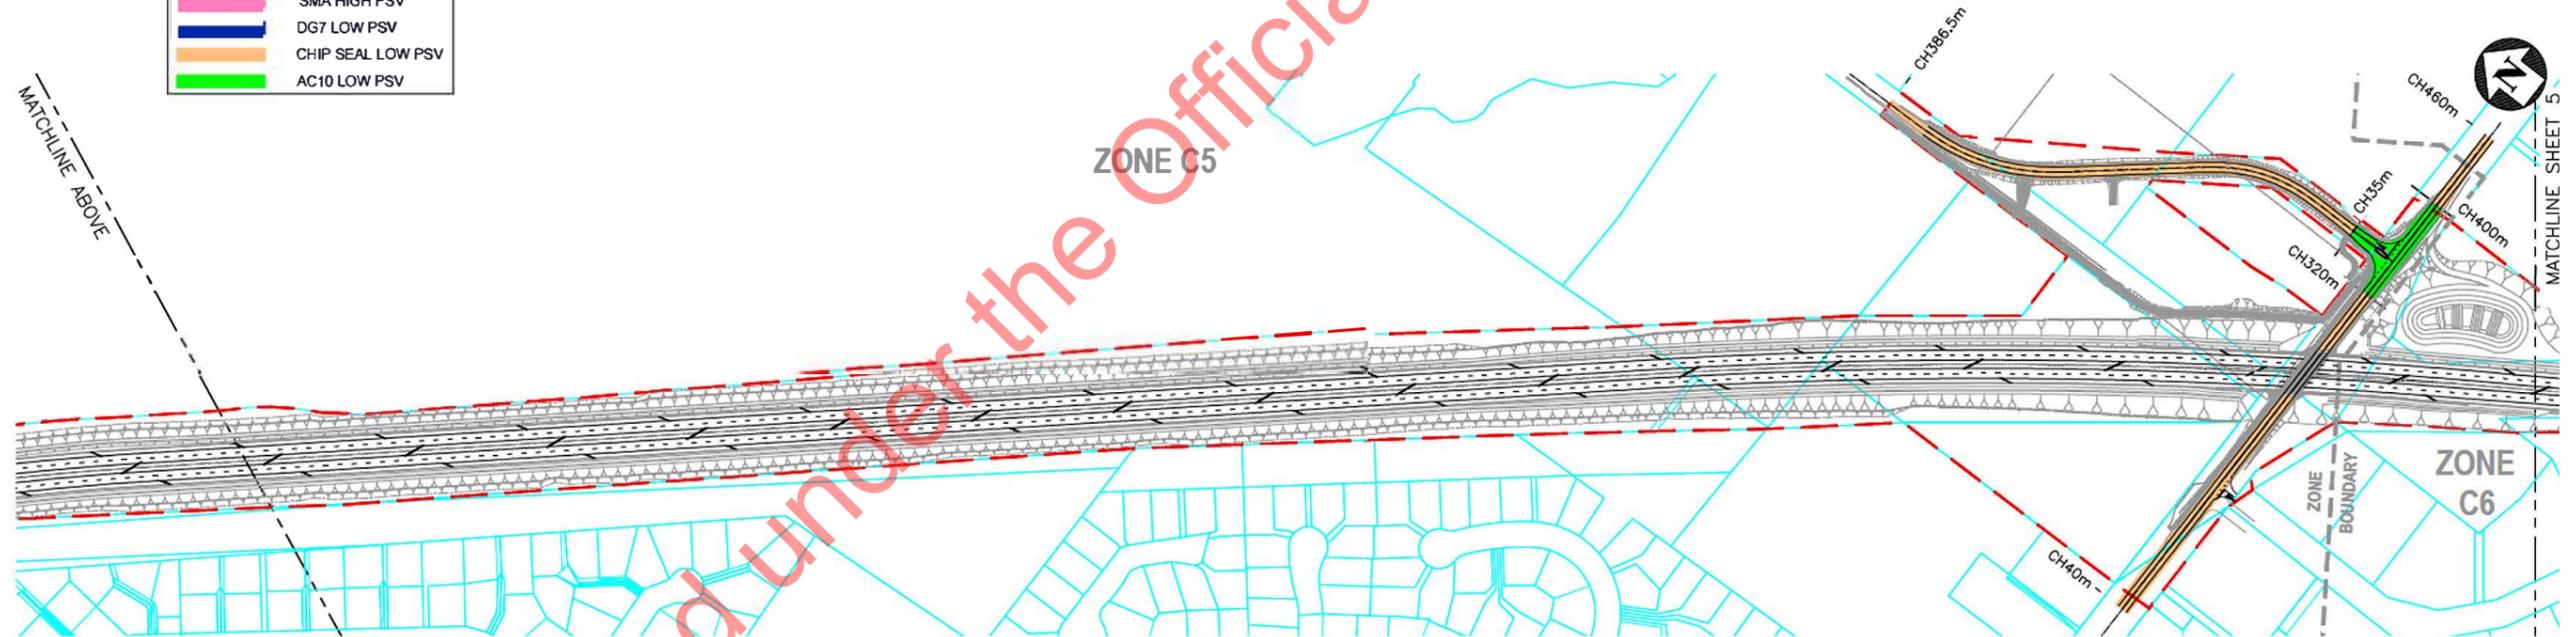

AB	AS-BUILT	03.11.15	Original Size	A1
Rev	Revision Description	Drawn	Designed	Approved


Approved for Issue	
§ 9(2)(a)	
WAIKATO EXPRESSWAY: TAMAHERE TO CAMBRIDGE SECTION	
SURFACING PLAN LOCAL ROADS SHEET 4 OF 5	Status AS-BUILT
Drawing Number C-115-014	Revision AB

This design is based on generally accepted practices and standards at the time it was prepared. No other warranty, expressed or implied, is made. It is prepared in accordance with the scope of work and for the purpose outlined in the contract dated 27 Sept. 2012. No responsibility is accepted for use of any part of this design in any other context or for any other purpose. URS accepts no liability for the use of this drawing where it has been provided in electronic format, nor for any changes made to it following its issue. URS considers the printed version to be binding. A hard copy of this drawing is held on file by URS and may be provided if requested.

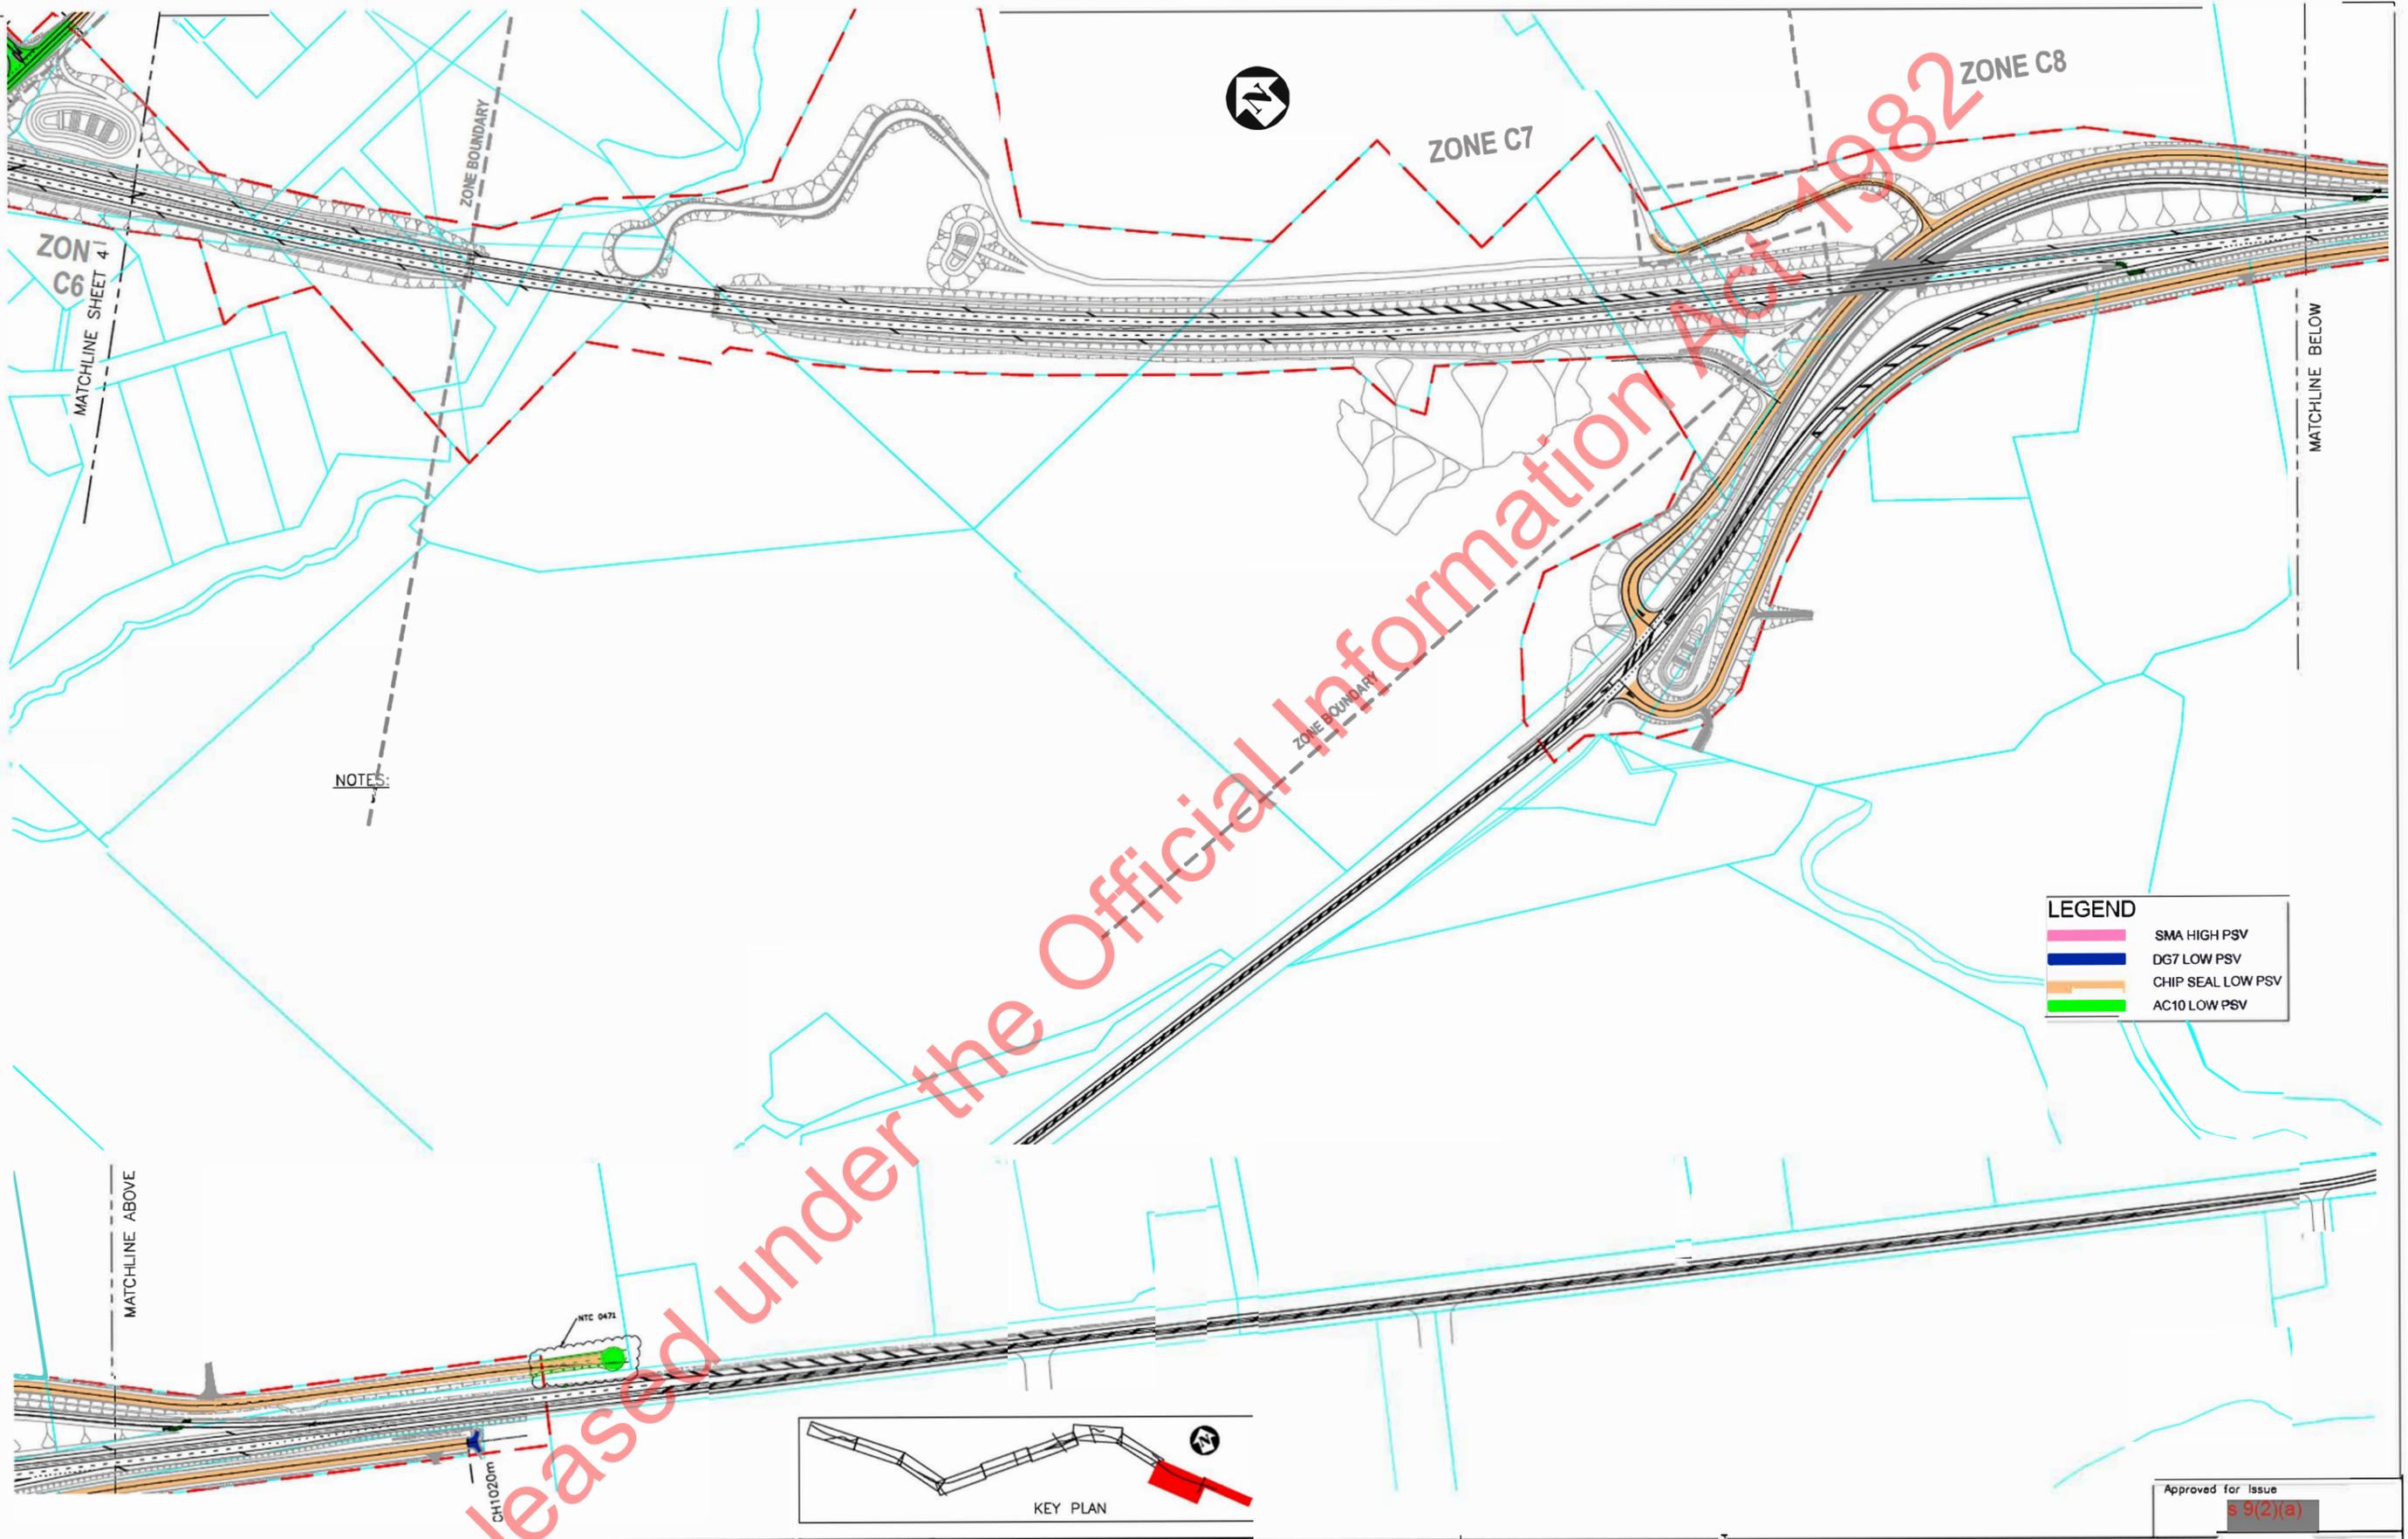

NOTES:

LEGEND	
	SMA HIGH PSV
	DG7 LOW PSV
	CHIP SEAL LOW PSV
	AC10 LOW PSV

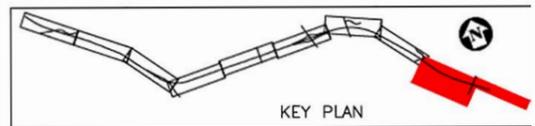

Approved for Issue
§ 9(2)(a)

Rev	Description	Drawn	Checked	Designed	Design Checked	Approved	Date
01	AS-BUILT REVIEW	§ 9(2)(a)		§ 9(2)(a)			23.05.17
AB	AS-BUILT						03.11.15

Tab	015
Scales	1:2500 A1 1:5000 A3
Original Size	A1

WAIKATO EXPRESSWAY: TAMAHERE TO CAMBRIDGE SECTION	
SURFACING PLAN LOCAL ROADS SHEET 5 OF 5	Status AS-BUILT
Drawing Number C-115-015	Revision AB