
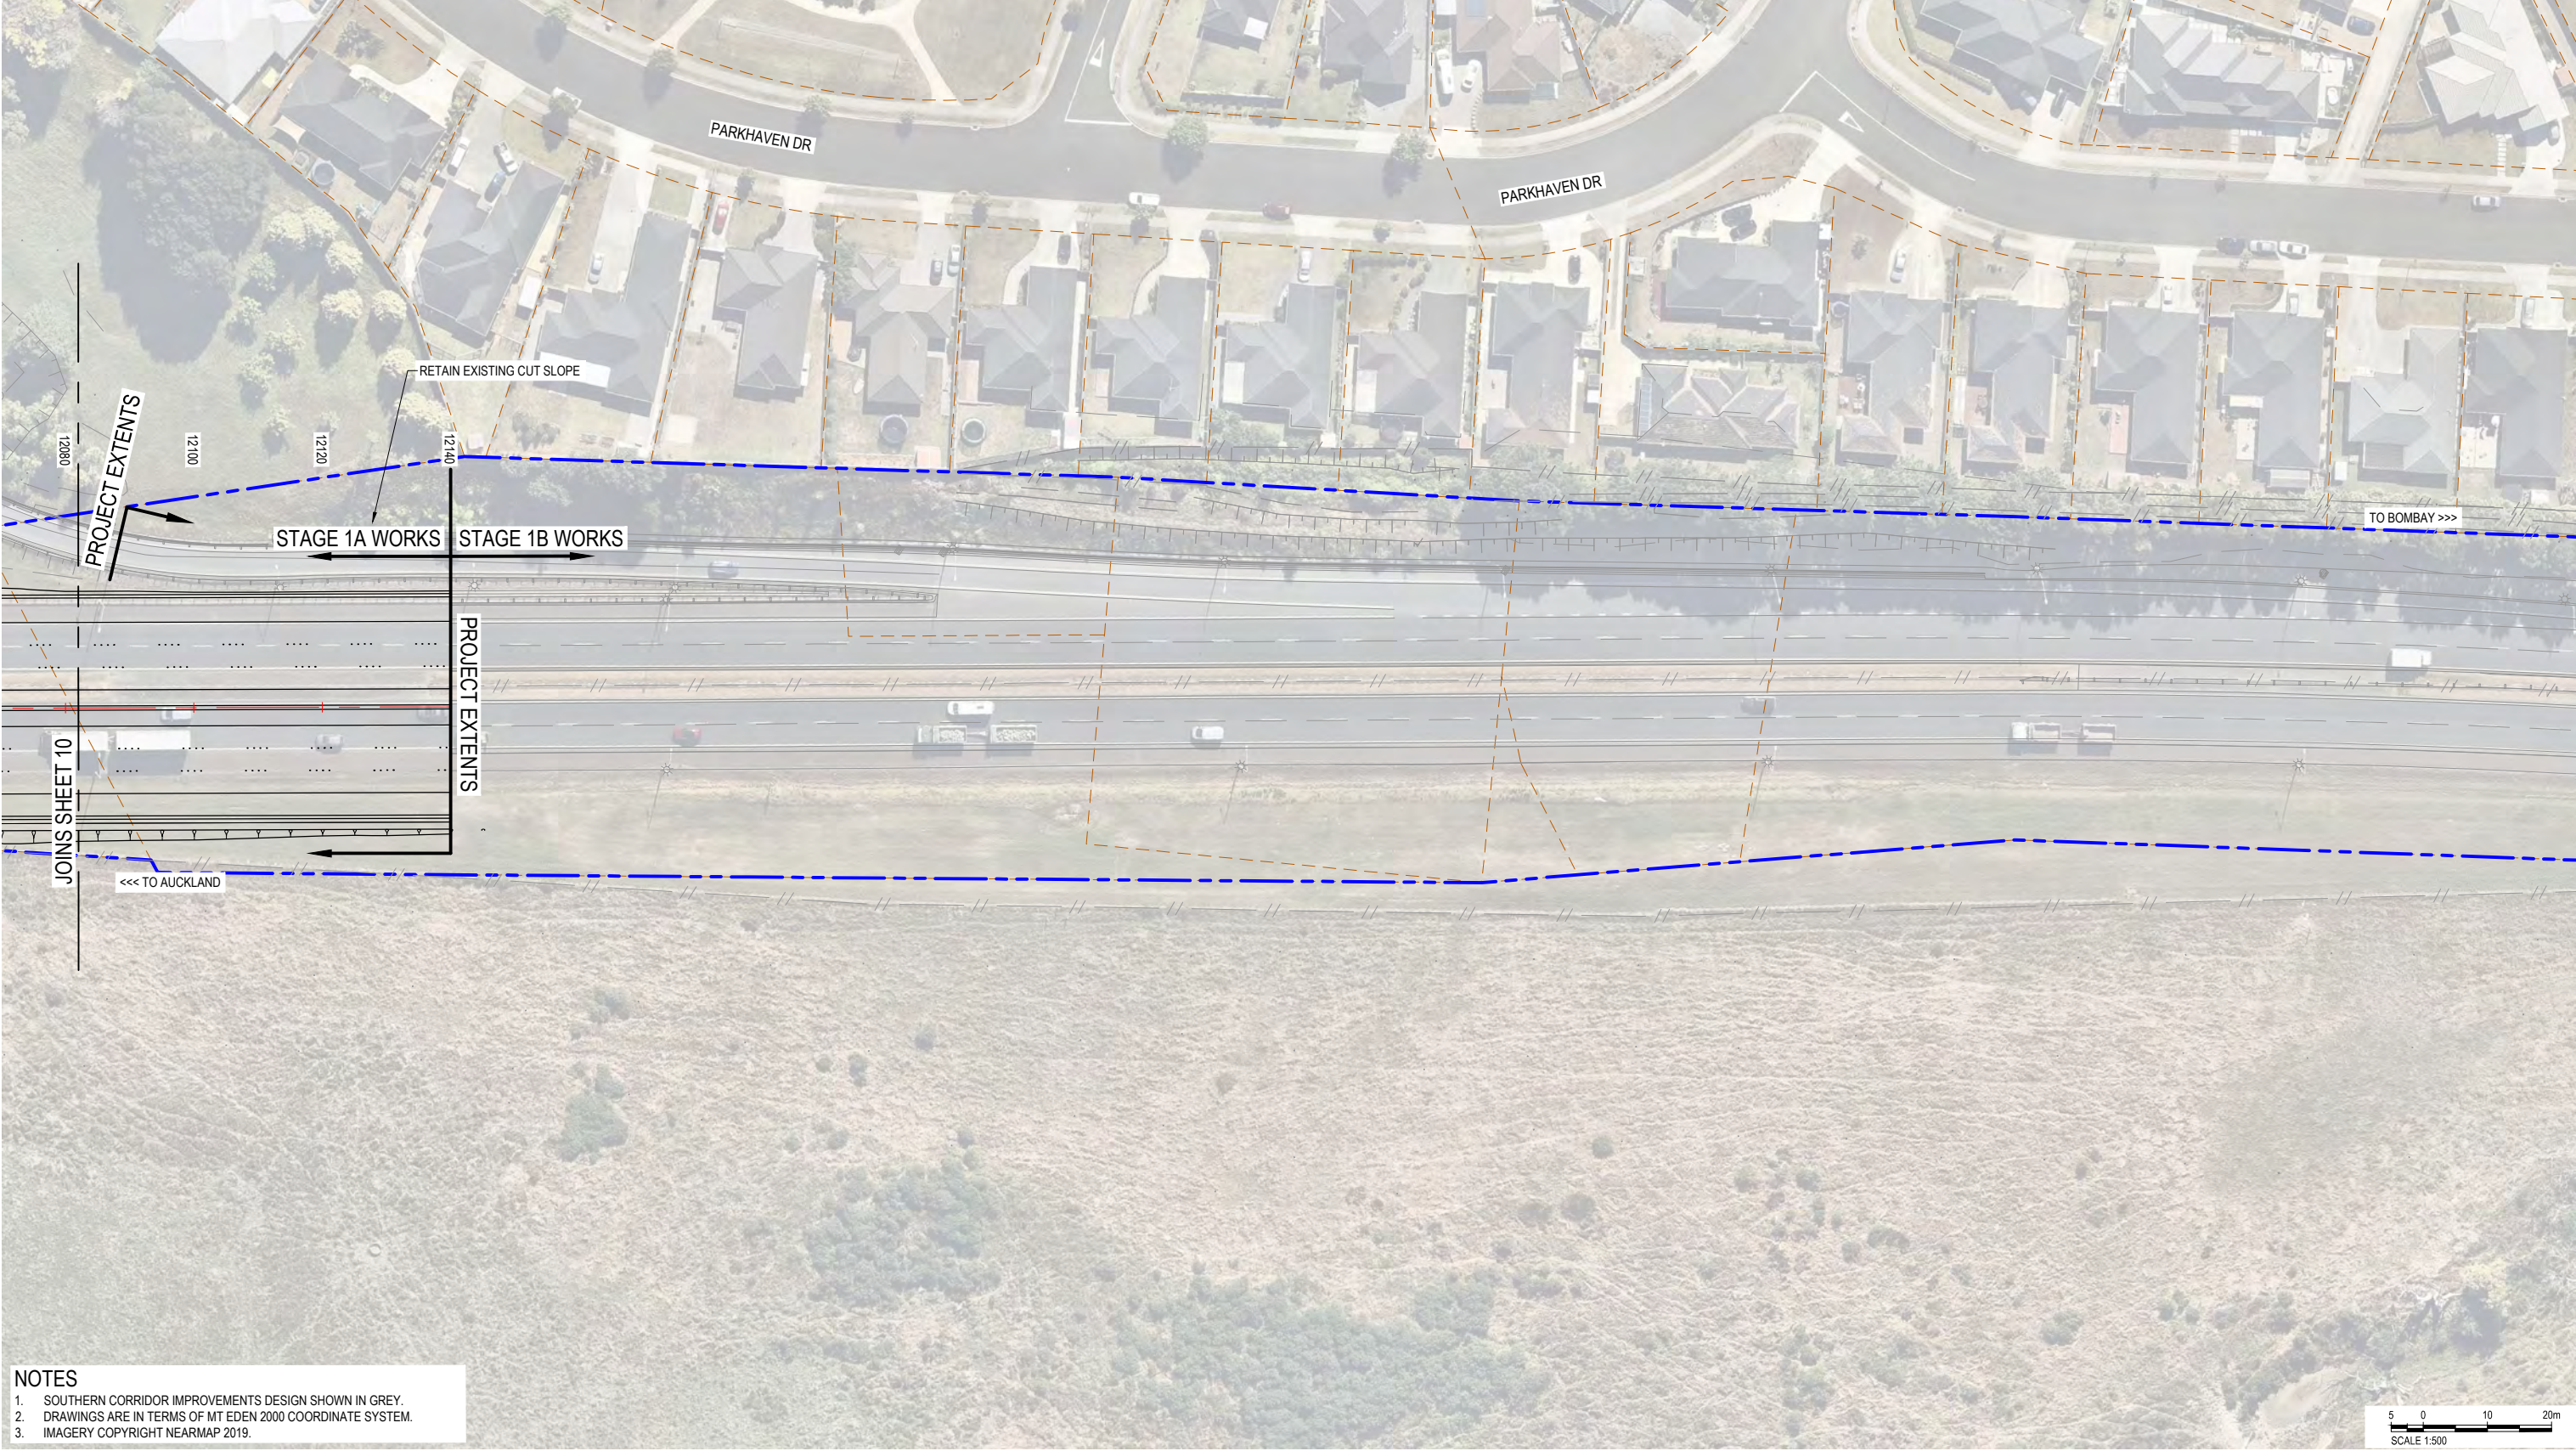


LEGEND	
EXISTING DESIGNATION BOUNDARY	
EXISTING PROPERTY BOUNDARY	
EXISTING BRIDGE EXTENTS	
PROPOSED BRIDGE EXTENTS	
MAINTENANCE BAY	
PROPOSED RETAINING WALL	
PROPOSED NOISE WALL ON RETAINING WALL	
PROPOSED NOISE WALL	
EXISTING NOISE WALL	
PROPOSED CULVERT	
EXISTING CULVERT	
EXISTING CULVERT TO BE ABANDONED	
AREA WITH RIPRAP COVERAGE	
CANTILEVER GANTRY	
PORTAL GANTRY	
TRUSS GANTRY	

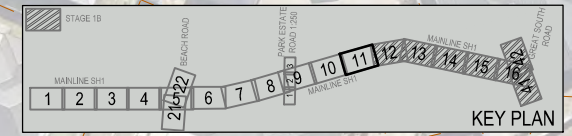



NOTES

- SOUTHERN CORRIDOR IMPROVEMENTS DESIGN SHOWN IN GREY.
- DRAWINGS ARE IN TERMS OF MT EDEN 2000 COORDINATE SYSTEM.
- IMAGERY COPYRIGHT NEARMAP 2019.


		CLIENT NZUP SH1 PAKAPURA TO DRURY SOUTH	REV 0	DATE 2021-02-25	REVISION DETAILS ISSUED FOR CONSTRUCTION	APPROVED R. LAUREN	SCALE 1:500	SIZE A1	FOR CONSTRUCTION	PROJECT NZUP SH1 PAKAPURA TO DRURY SOUTH
		DRAWN A. BURGER	DESIGNED I. BROWN	REVIEWED R. LAUREN	APPROVED J. HIND	DATE 2021-02-25	TITLE GENERAL ARRANGEMENT LAYOUT PLAN SHEET 11			
		DRAWING No. 506207	PROJECT No. 0350	AREA DRG	TYPE RR	DISC 0111	NUMBER 0	REV 0		

LEGEND	
EXISTING DESIGNATION BOUNDARY	--- (Blue dashed line)
PROPOSED DESIGNATION BOUNDARY	--- (Pink dashed line)
EXISTING PROPERTY BOUNDARY	--- (Orange dashed line)
EXISTING BRIDGE EXTENTS	▨ (Hatched pattern)
PROPOSED BRIDGE EXTENTS	▨ (Red hatched pattern)
MAINTENANCE BAY	■ (Yellow)
PROPOSED SHARED USE PATH	■ (Light Green)
PROPOSED FOOTPATH	■ (Light Blue)
PROPOSED CYCLE PATH	■ (Green)
PROPOSED RETAINING WALL	▨ (Red hatched pattern)
PROPOSED NOISE WALL	▨ (Yellow hatched pattern)
EXISTING NOISE WALL	▨ (Light Green hatched pattern)
PROPOSED BOUNDARY WALL	▨ (Light Blue hatched pattern)
EXISTING BOUNDARY WALL	▨ (Green hatched pattern)
CONCRETE INFILL	— (Red line)
CONCRETE MAINTENANCE STRIP	— (Pink line)
BUFFER STRIP	— (Light Green line)
LANDSCAPING	— (Light Blue line)
HIGH FRICTION WEARING COURSE	— (Orange line)

NOTE: AERIAL PHOTOGRAPH IS OUT OF ALIGNMENT IN THIS LOCATION.

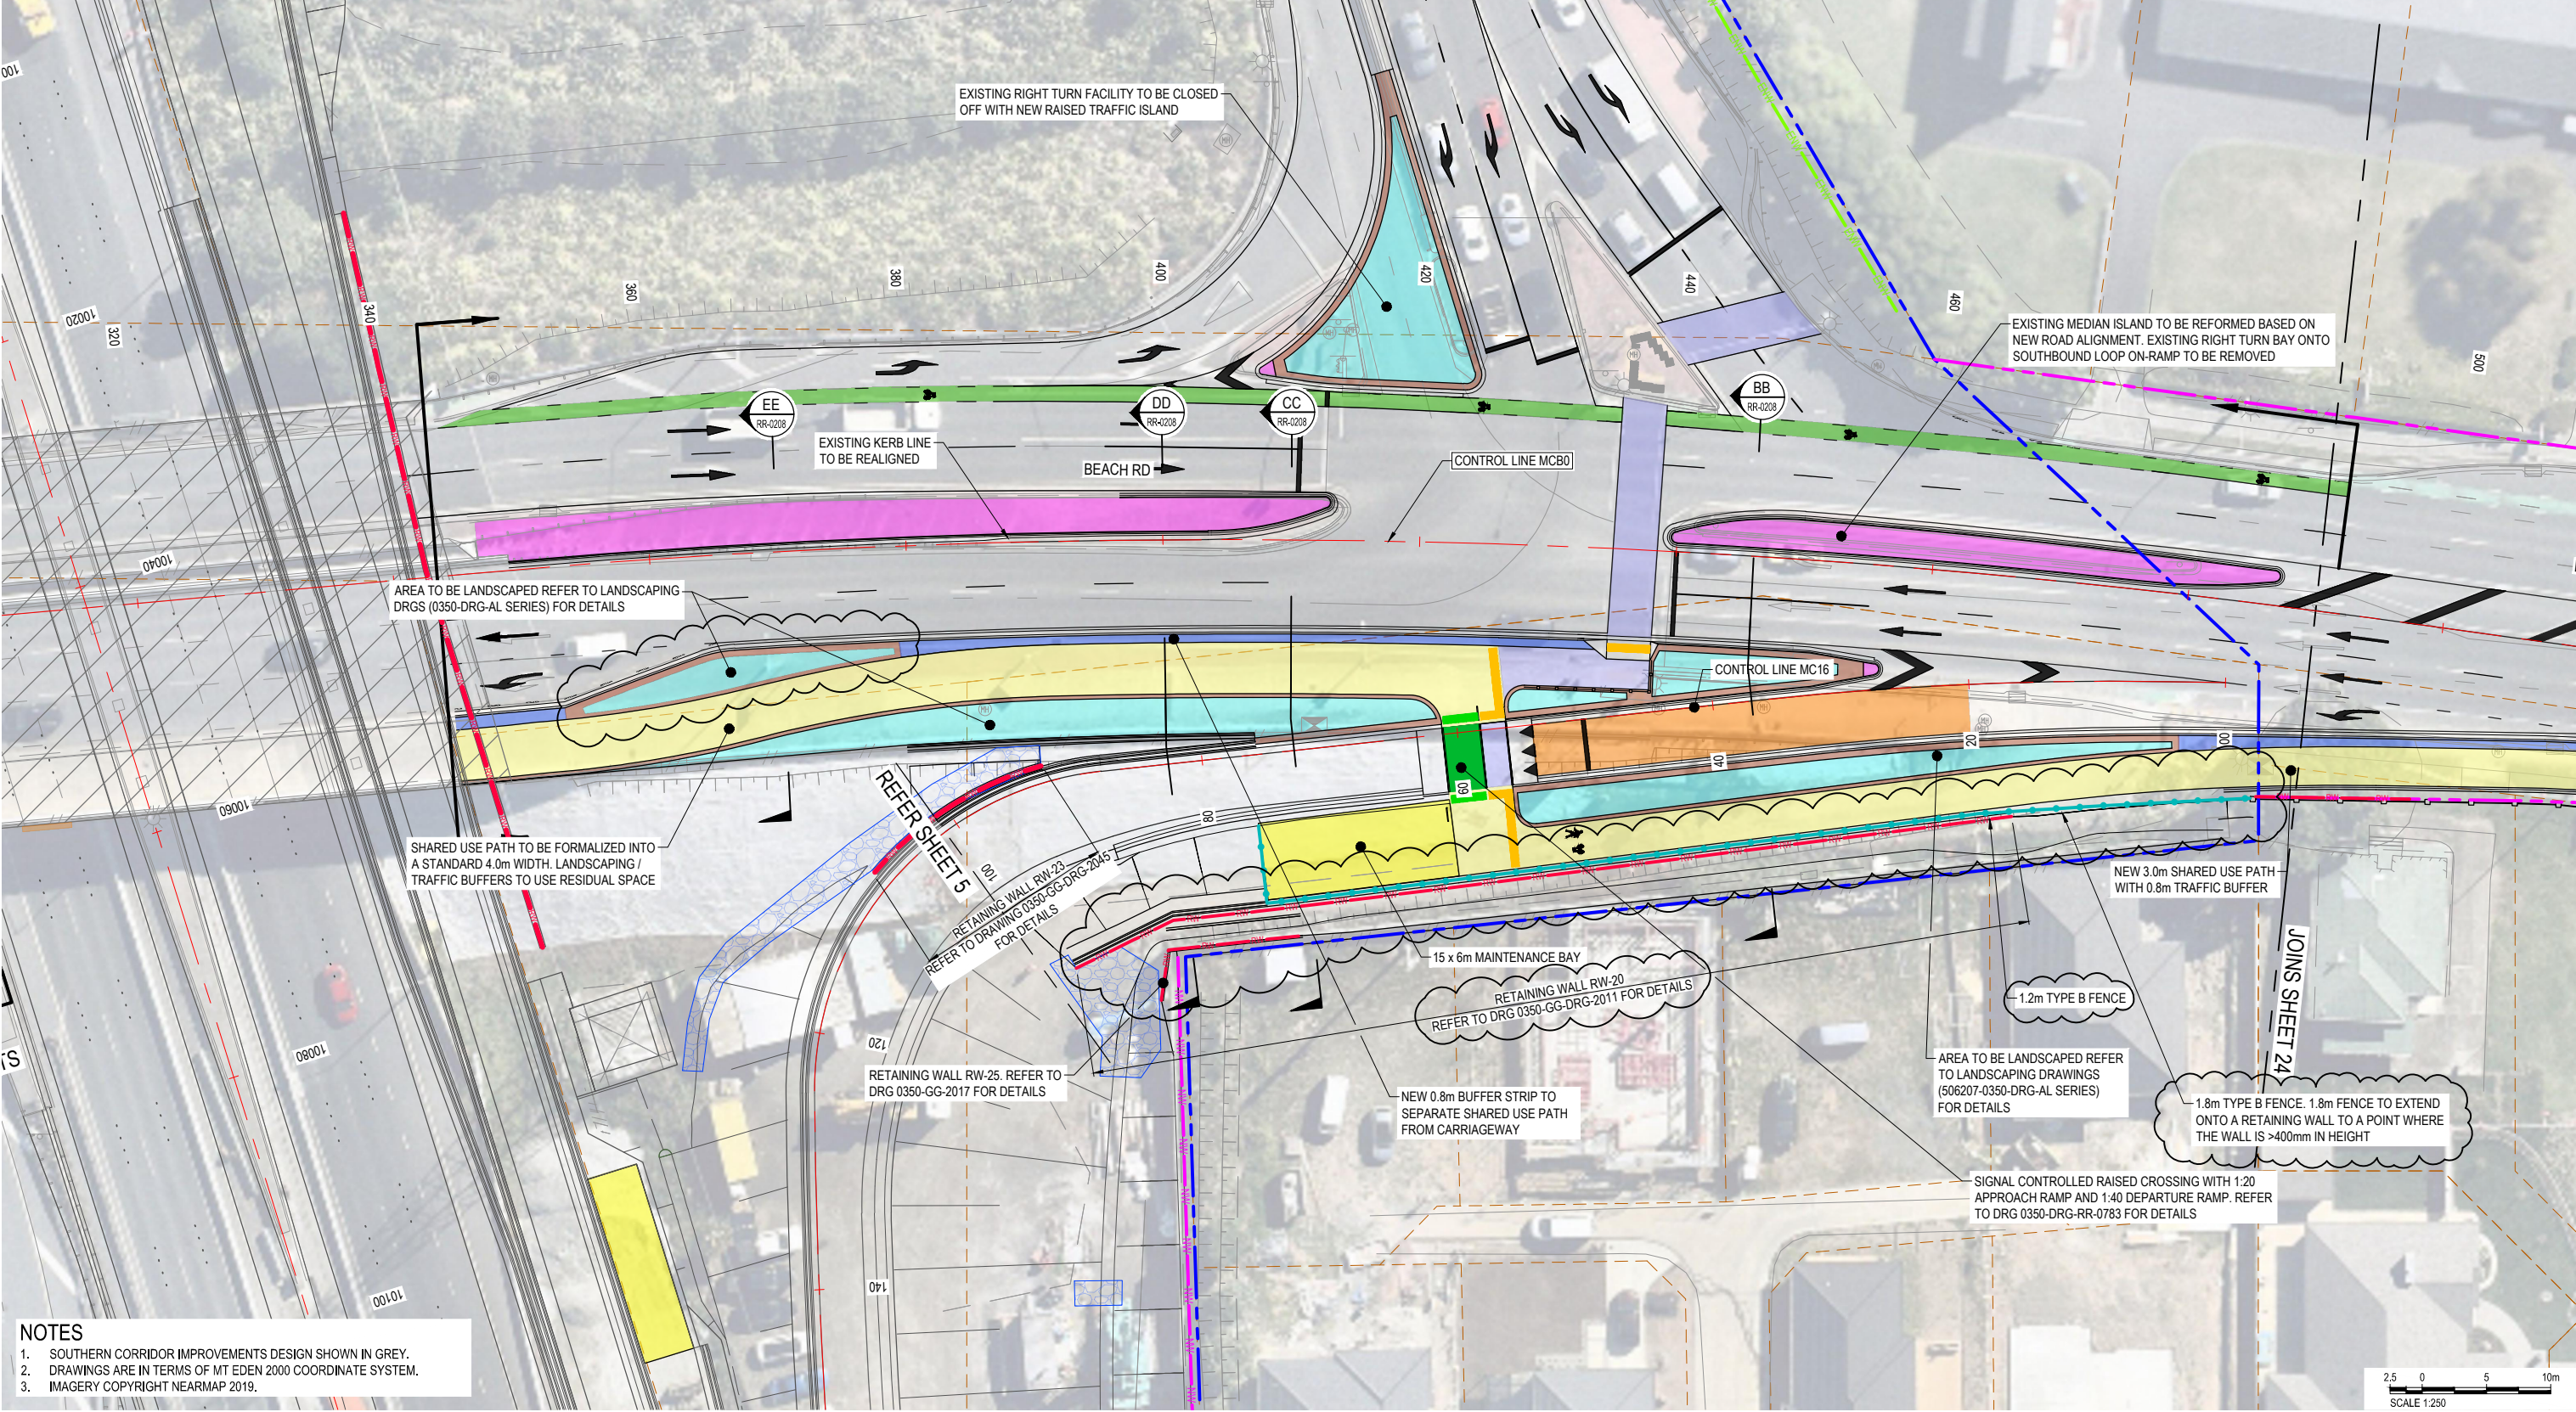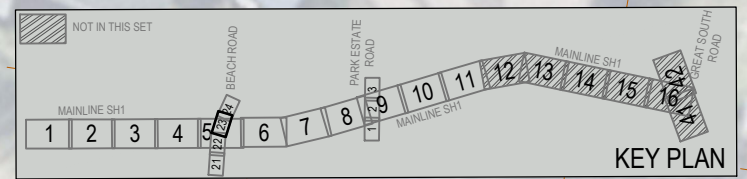



- NOTES**
- SOUTHERN CORRIDOR IMPROVEMENTS DESIGN SHOWN IN GREY.
 - DRAWINGS ARE IN TERMS OF MT EDEN 2000 COORDINATE SYSTEM.
 - IMAGERY COPYRIGHT NEARMAP 2019.

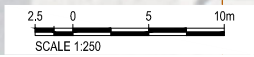

	CLIENT	REV	DATE	REVISION DETAILS	APPROVED	SCALE	SIZE	FOR CONSTRUCTION	PROJECT	NZUP SH1 PAKAPURA TO DRURY						
		1	2022-08-02	HOLD CLOUD REMOVED FROM RETAINING WALL	R. LAUREN	1:250	A1									
		0	2021-12-17	PAPAKURA SB ON-RAMP INCORPORATED INTO DESIGN	R.LAUREN											
						DRAWN		APPROVED								
						A. BURGER		DATE								
						I. BROWN		2022-08-02								
						REVIEWED		J. HIND		TITLE						
						R. LAUREN		J. HIND		GENERAL ARRANGEMENT LAYOUT PLAN						
										SHEET 23						
										DRAWING No.	PROJECT No.	AREA	TYPE	DISC	NUMBER	REV
										506207	0350	DRG	RR	0123	1	



LEGEND			
EXISTING DESIGNATION BOUNDARY		PROPOSED NOISE WALL ON RETAINING WALL	
EXISTING PROPERTY BOUNDARY		PROPOSED NOISE WALL	
EXISTING BRIDGE EXTENTS		EXISTING NOISE WALL	
PROPOSED BRIDGE EXTENTS		CANTILEVER GANTRY	
PROPOSED RETAINING WALL			
		PORTAL GANTRY	
		TRUSS GANTRY	
		CYCLEWAY	
		FOOTPATH	
		SHARED USE PATH	

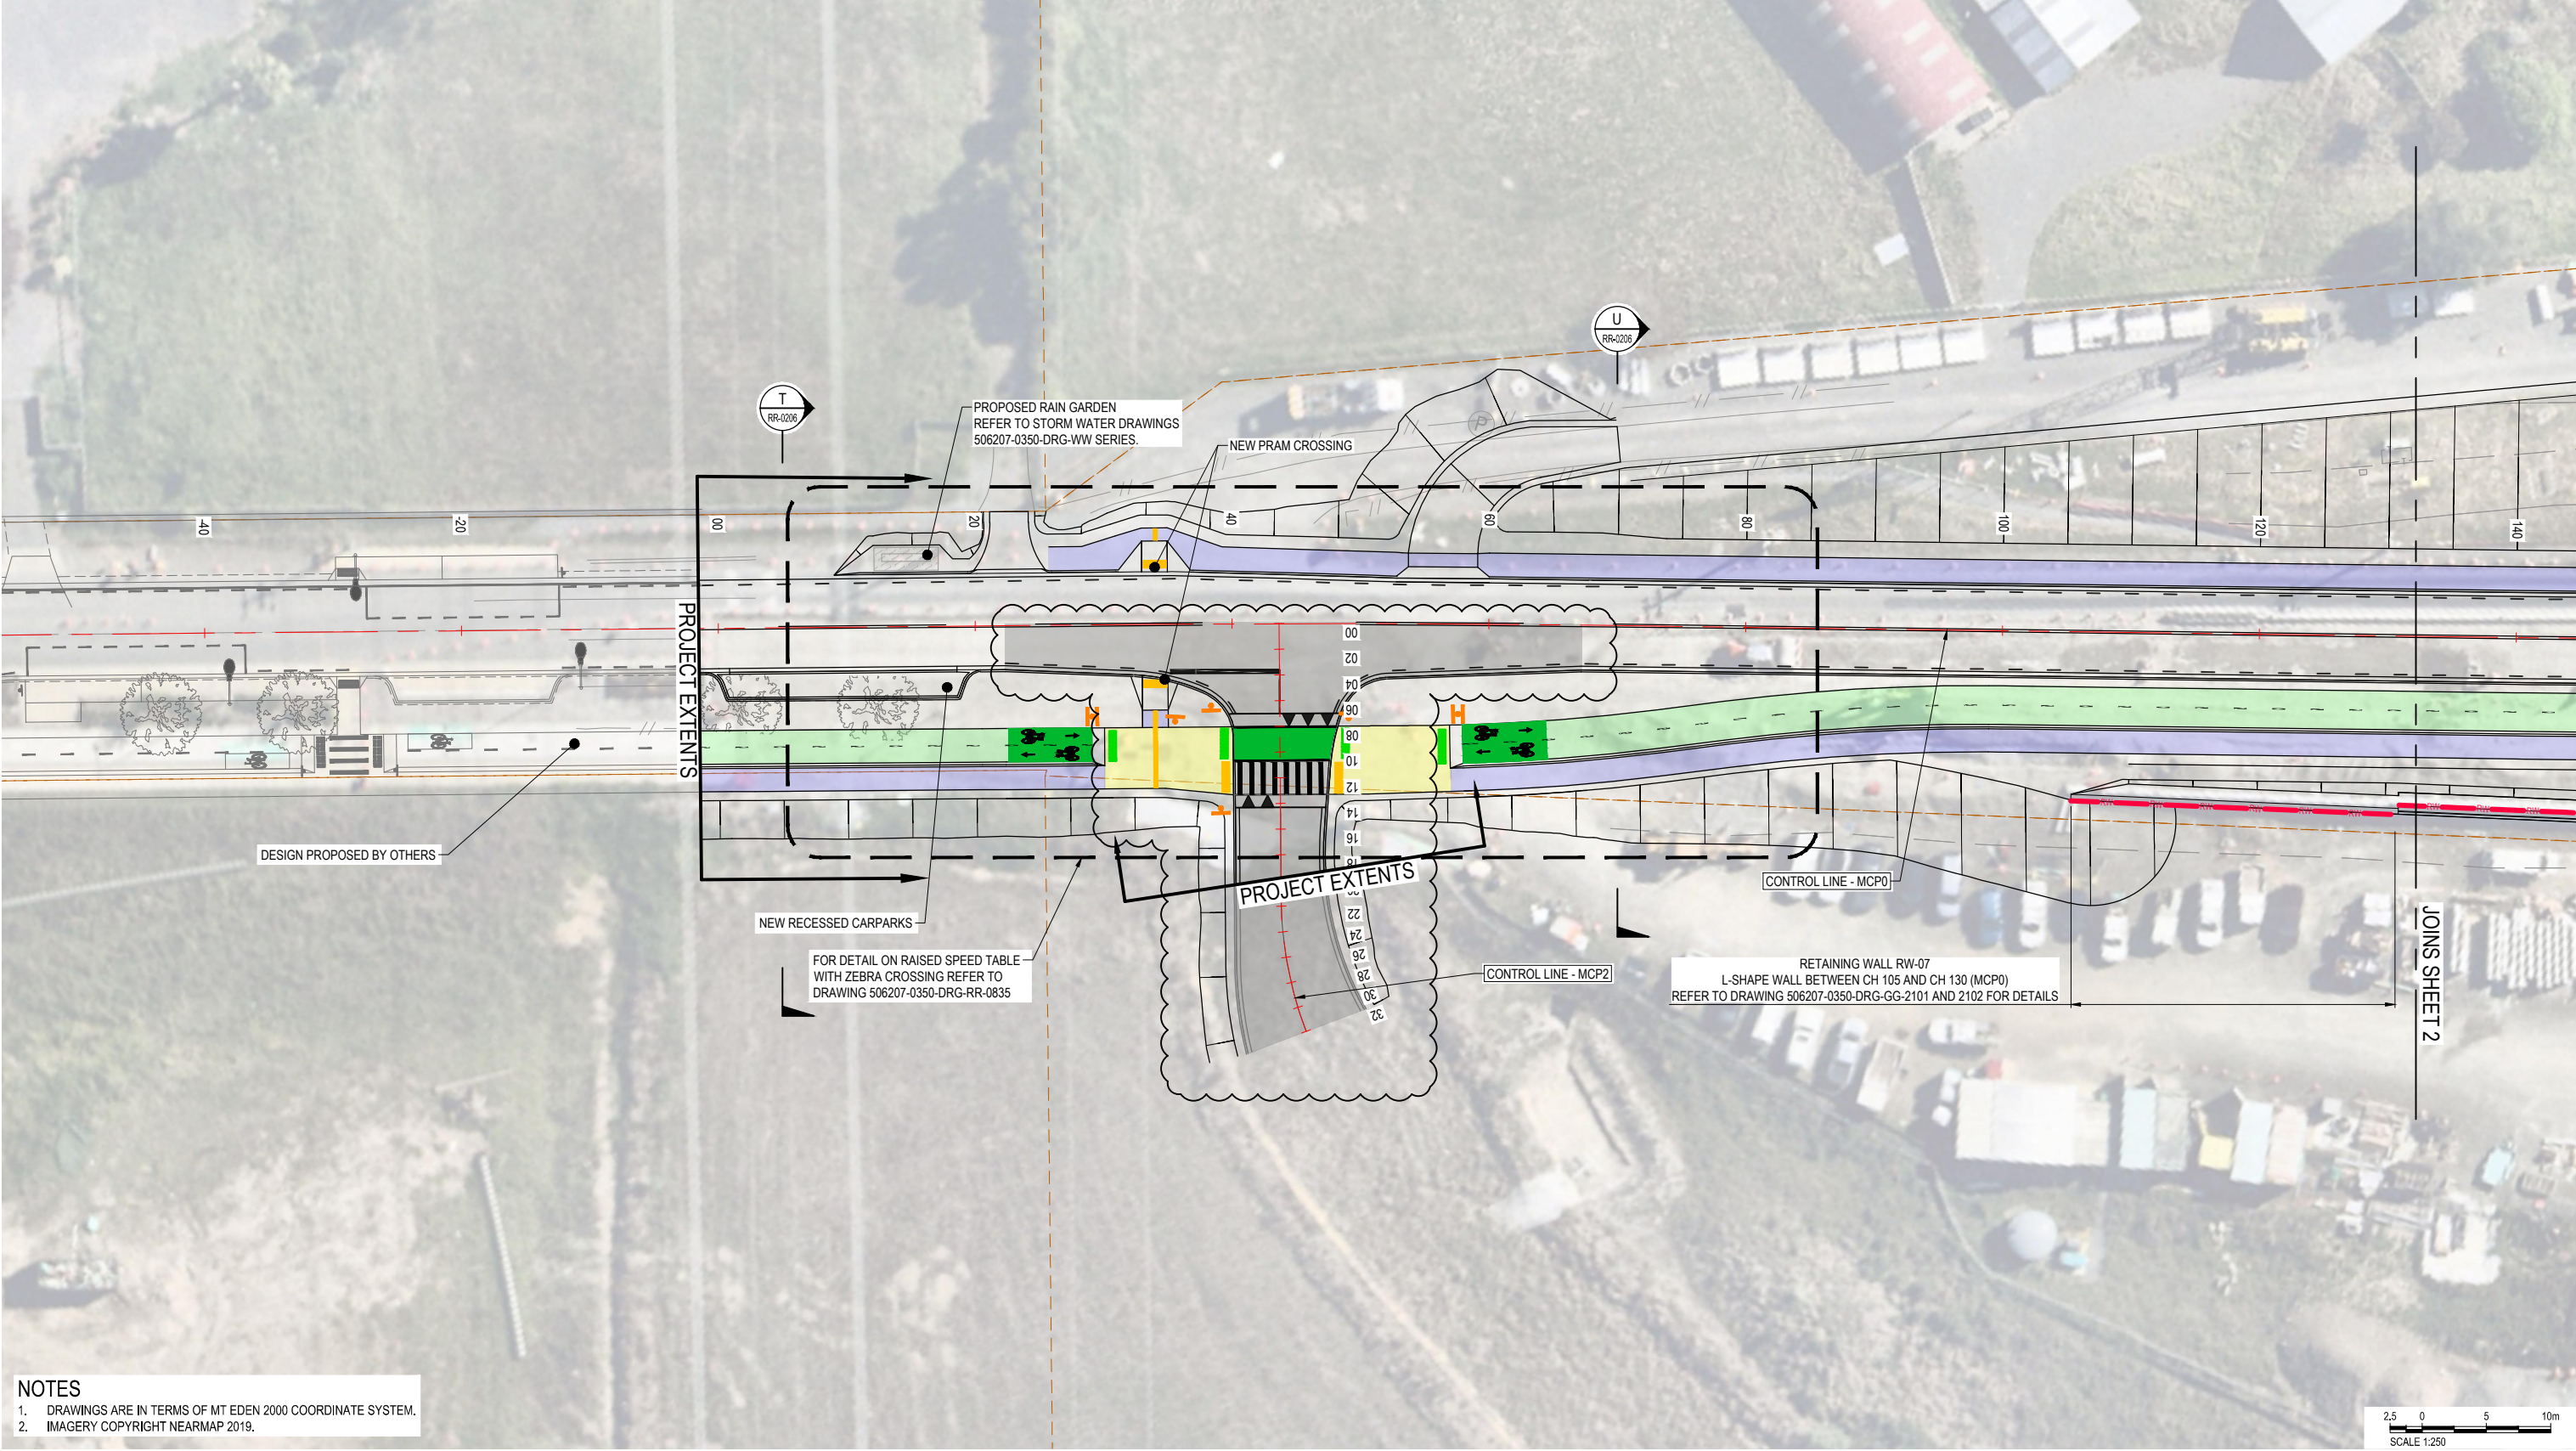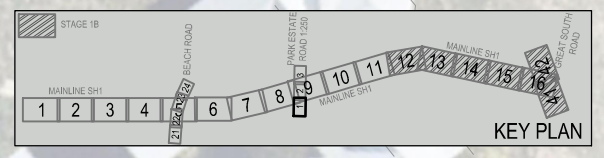


NOTES
 1. DRAWINGS ARE IN TERMS OF MT EDEN 2000 COORDINATE SYSTEM.
 2. IMAGERY COPYRIGHT NEARMAP 2019.

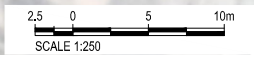

REV	DATE	REVISION DETAILS	APPROVED
4	2022-09-23	INTERSECTION RELOCATED	R. LAUREN
3	2022-01-27	LINE HOLD CLOUD ADDED	R. LAUREN
2	2021-09-24	LINE MARKING AT INTERSECTION REVISED	R. LAUREN
1	2021-08-03	PARK ESTATE RD LAYOUT UPDATED	R. LAUREN
0	2021-02-25	ISSUED FOR CONSTRUCTION	R. LAUREN

SCALE	SIZE
1:250	A1
DRAWN	
A. BURGER	
DESIGNED	
I. BROWN	
REVIEWED	
R. LAUREN	

FOR CONSTRUCTION	
APPROVED	DATE
J. HIND	2022-09-23
J. HIND	

PROJECT	NZUP SH1 PAKAPURA TO DRURY	
TITLE	GENERAL ARRANGEMENT LAYOUT PLAN PARK ESTATE ROAD SHEET 1	
DRAWING No.	506207	0350
AREA	DRG	RR
NUMBER	0131	
REV		4

